

Washington  
 H 2013  
 7/1/80

MISSISSIPPI  
 BOARD OF WATER COMMISSIONERS  
 416 North State Street  
 Jackson, Mississippi 39201

WATER WELL DRILLERS LOG

1 July 1980 Lambert Drilling Wash  
 date well completed firm name county well located

LANDOWNER:  
 J. McDonnell  
 Wilmont  
 (mailing address)

WELL LOCATION:  
 sec. 23 T. 17 N R. 7 E  
 8 miles S of Leland.  
 (distance) (direction) (nearest town)

WELL PURPOSE: home  
 (home, irrigation, municipal, industrial)

WELL COMPLETION DATA:  
 (1) diameter (inches) 2  
 (2) total depth (feet) 420  
 (3) static water level (feet) 34 below top of ground.  
 (4) casing PVC, 410 (material) (depth)  
 2 (size) if telescope see back.  
 (5) screen 10, 420-410 (length) (depth to top)  
 2, PVC (size) (material)  
 (6) pump 1, 10 (HP) (yield gpm)  
 elect (type power)  
 (7) electric log no (yes or no)  
 (organization running log)

(8) how well bottom plugged back pres.  
 DRILLERS REMARKS:

description of formations encountered	from	to
Mixed	0	10
Clay	10	25
sand	25	75
gravel	75	165
sand	165	265
Clay sand	265	330
Sand. med	330	390
Sand.	390	420


DEPT. OF NATURAL RESOURCES  
 BUREAU OF LAND & WATER RESOURCES

SEP 8 - 1980

RECEIVED

If well telescopes please sketch and show depths.

GROUND LEVEL

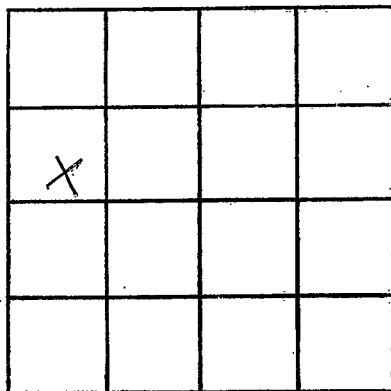

SECTION 23

Please indicate well location X.

ADDITIONAL INFORMATION

If more than one screen,  
show locations of each on sketch.