

Washington
H 2014
8-23-80

MISSISSIPPI
BOARD OF WATER COMMISSIONERS
416 North State Street
Jackson, Mississippi 39201

WATER WELL DRILLERS LOG

23 Aug 1980 Lambert Drilling Wash
date well completed firm name county well located

LANDOWNER:
American Hoechst
Leland, MS
(mailing address)

WELL LOCATION:
sec 10 T 17 N R 4 E
5 miles S of Leland
(distance) (direction) (nearest town)

WELL PURPOSE: farm
(home, irrigation, municipal, industrial)

- WELL COMPLETION DATA:
- (1) diameter (inches) 4x2
 - (2) total depth (feet) 420
 - (3) static water level (feet) 31 below/above top of ground.
 - (4) casing PVC, 400,
(material) (depth)
4x2 if telescope see back.
(size)
 - (5) screen 20, 420-400
(length) (depth to top)
2", 33
(size) (material)
 - (6) pump 3, 35
(HP) (yield gpm)
elect
(type power)
 - (7) electric log (yes or no) _____
 - (8) how well bottom plugged _____
each PVC

DRILLERS REMARKS:

description of formations encountered	from	to
<u>mixed</u>	<u>0</u>	<u>15</u>
<u>sand</u>	<u>15</u>	<u>60</u>
<u>sand gravel</u>	<u>60</u>	<u>175</u>
<u>clay</u>	<u>175</u>	<u>300</u>
<u>sand & clay</u>	<u>300</u>	<u>350</u>
<u>sand etc</u>	<u>350</u>	<u>420</u>

DEPT. OF NATURAL RESOURCES
BUREAU OF LAND & WATER RESOURCES

DEC 15 1980

RECEIVED


If well telescopes please sketch and show depths.

GROUND LEVEL

1600 4"

1400 2"

420 2" screen

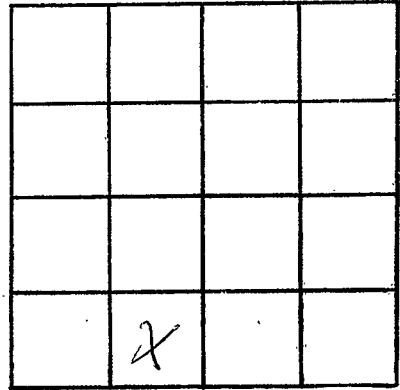

SECTION 10

Please indicate well location X.

ADDITIONAL INFORMATION

If more than one screen, show locations of each on sketch.