

MISSISSIPPI DEPARTMENT OF NATURAL RESOURCES

Bureau of Land and Water Resources

Southport Mall

P.O. Box 10631

Jackson, Mississippi 39209

WATER WELL DRILLERS LOG

WASHINGTON
H 2015
4/8/81
8'apv 1981

Lambert Drilling Wash.
firm name county well located

LANDOWNER:	description of formations encountered	from	to
W. Hoover	Clay	0	32
Black Bayou Rd. (mailing address)	Sand & gravel	32	75
WELL LOCATION: sec. 32 T 17 N R 7 E 8 miles S/E of Brookli (distance) (direction) (nearest town)	Clay blue	75	165
WELL PURPOSE: name (home, irrigation, municipal, industrial)	Clay & sand	165	240
WELL COMPLETION DATA:	Sand & clay	240	280
(1) diameter (inches) 4 1/2	Sand	280	300
(2) total depth (feet) 370	Sand streaky	300	340
(3) static water level (feet) 35 below top of ground.	Sand	340	395
(4) casing PVC 370 (material) (depth) 4 1/2 (size) If telescope see back.			
(5) screen 20 390-370 (length) (depth to top) 2 (size) PVC (material)			
(6) pump 1 20 (HP) (yield gpm) elect (type power)			
(7) electric log no (yes or no) (organization running log)			
(8) how well bottom plugged Back Press.			
DRILLERS REMARKS:			

DEPT. OF NATURAL RESOURCES
BUREAU OF LAND & WATER RESOURCES

MAY 18 1981

RECEIVED


If well telescopes please sketch and show depths.

GROUND LEVEL

140 4''

370 2''

390 2 1/2''

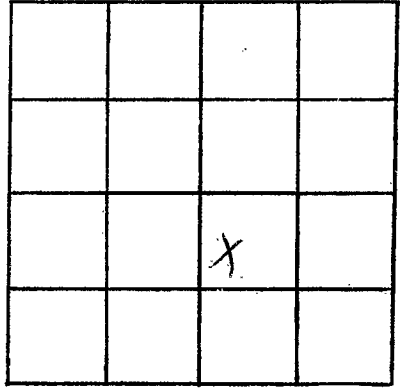

SECTION 32

Please indicate well location X.

ADDITIONAL INFORMATION

If more than one screen, show locations of each on sketch.