

MISSISSIPPI DEPARTMENT OF NATURAL RESOURCES

Bureau of Land and Water Resources

Southport Mall

P.O. Box 10631

Jackson, Mississippi 39209

WATER WELL DRILLERS LOG

WASHINGTON  
H 2016  
7-20-81

20 July 1981 Hambert Drilling Wash  
 date well completed firm name county well located

LANDOWNER:  
Jim Cambell  
Leland, Miss  
 (mailing address)

WELL LOCATION:  
 sec 32 T 17 N R 7 E  
8 miles S/E of Greenwood  
 (distance) (direction) (nearest town)

WELL PURPOSE: domestic  
 (home, irrigation, municipal, industrial)

WELL COMPLETION DATA:

(1) diameter (inches) 2

(2) total depth (feet) 395

(3) static water level (feet) 11 below above top of ground.

(4) casing PVC, 385  
 (material) (depth)  
2 if telescope see back.  
 (size)

(5) screen 10, 395-385  
 (length) (depth to top)  
2, PVC  
 (size) (material)

(6) pump 1, 10  
 (HP) (yield gpm)  
elect  
 (type power)

(7) electric log no.  
 (yes or no)

(organization running log)

(8) how well bottom plugged  
back press

description of formations encountered	depth	
	from	to
<u>Clay</u>	<u>0</u>	<u>30</u>
<u>Sand &amp; gravel</u>	<u>30</u>	<u>75</u>
<u>blue clay</u>	<u>75</u>	<u>165</u>
<u>Clay &amp; sand</u>	<u>165</u>	<u>240</u>
<u>Sand &amp; clay</u>	<u>240</u>	<u>330</u>
<u>Sand</u>	<u>330</u>	<u>390</u>

DEPT. OF NATURAL RESOURCES  
 BUREAU OF LAND & WATER RESOURCES


SEP 16 1981

RECEIVED

DRILLERS REMARKS:

If well telescopes please sketch and show depths.

GROUND LEVEL

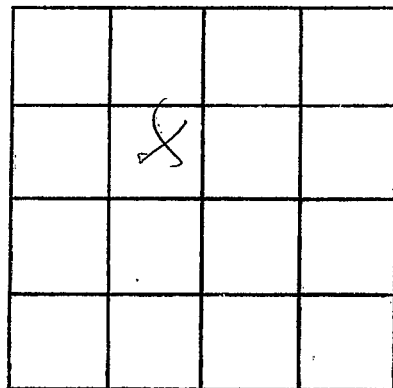

SECTION 82

Please indicate well location X.

ADDITIONAL INFORMATION

If more than one screen,  
show locations of each on sketch.