

MISSISSIPPI DEPARTMENT OF NATURAL RESOURCES

Bureau of Land and Water Resources

Southport Mall

P.O. Box 10631

Jackson, Mississippi 39209

WATER WELL DRILLERS LOG

Washington
H
2018

30 mar 1982 Lambert Drilling Co. Wash Wash
 date well completed firm name county well located

LANDOWNER:
American Hoechst
Island, Miss.
 (mailing address)

WELL LOCATION:
 sec. 5 T 17 N R. 7 E
6 miles S of Island
 (distance) (direction) (nearest town)

WELL PURPOSE: well
 (home, irrigation, municipal, industrial)

WELL COMPLETION DATA:

(1) diameter (inches) 4x2

(2) total depth (feet) 720

(3) static water level (feet) 26 below above top of ground.

(4) casing PVC 700
 (material) (depth)
4x2 if telescope see back.
 (size)

(5) screen 20 720-700
 (length) (depth to top)
2 1/2 DS
 (size) (material)

(6) pump 2 35
 (HP) (yield gpm)
elect
 (type power)

(7) electric log (yes or no) _____
 (organization running log) _____

(8) how well bottom plugged back press.

description of formations encountered	from	to
clay	0	30
sand	30	70
pea gravel	70	185
clay	185	265
sand	265	460
clay	460	510
sand	510	630
sand	630	720
sand pine	720	760

DEPT. OF NATURAL RESOURCES
 BUREAU OF LAND & WATER RESOURCES

MAY 18 1982

RECEIVED

DRILLERS REMARKS:


If well telescopes please sketch and show depths.

GROUND LEVEL

180 4"

700 2"

720 2" sc.

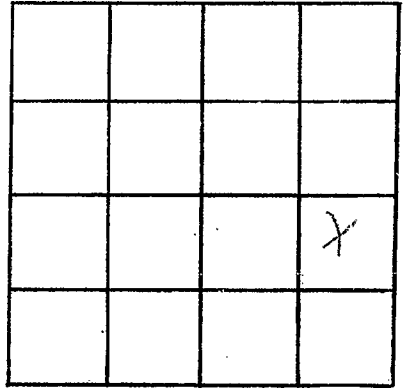

SECTION 5

Please indicate well location X.

ADDITIONAL INFORMATION

A series of horizontal lines for writing additional information.

If more than one screen, show locations of each on sketch.