

MISSISSIPPI DEPARTMENT OF NATURAL RESOURCES

Bureau of Land and Water Resources

Southport Mall

P.O. Box 10631

Jackson, Mississippi 39209

WATER WELL DRILLERS LOG

Washington
H
2019

4-25

1982 Schultz Drilling

Washington

date well completed

firm name

county well located

LANDOWNER: Leroy Wright

Rt 2.

Greenville MS

(mailing address)

WELL LOCATION:

sec. 17 T. 17 N.

R. 7 E.

5 miles S E of Greenville

(distance) (direction) (nearest town)

WELL PURPOSE: home
(home, irrigation, municipal, industrial)

WELL COMPLETION DATA:

(1) diameter (inches) 2"
(2) total depth (feet) 480'

(3) static water level (feet) 30' below top of ground.

(4) casing PVC 470'
(material) (depth)

(size) if telescope see back.

(5) screen 10' 470'
(length) (depth to top)

2" PVC wrapped
(size) (material)

(6) pump 1 9
(HP) (yield gpm)

ele
(type power)

(7) electric log NO
(yes or no)

(organization running log)

(8) how well bottom plugged b/w

description of formations encountered

from

to

Clay	0	20
sand and gravel	20	75
Clay	75	130
Sandy clay	130	340
Clay	340	380
SAND	380	480

DEPT. OF NATURAL RESOURCES
BUREAU OF LAND & WATER


MAY 14 1982

RECEIVED

DRILLERS REMARKS:

If well telescopes please sketch and show depths.

GROUND LEVEL

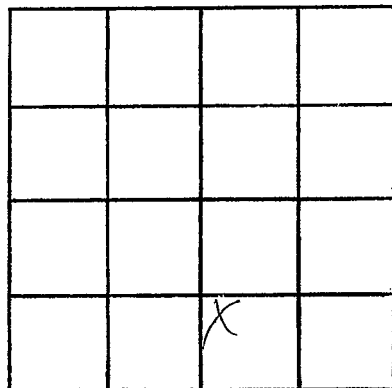

SECTION _____

Please indicate well location X.

ADDITIONAL INFORMATION

If more than one screen,
show locations of each on sketch.