

MISSISSIPPI DEPARTMENT OF NATURAL RESOURCES

Bureau of Land and Water Resources

Southport Mall

P.O. Box 10631

Jackson, Mississippi 39209

WATER WELL DRILLERS LOG

Washington
H 2020
5-10-83

5-10 1983 Schultz Drilling Washington
date well completed firm name county well located

LANDOWNER:	description of formations encountered	from	to
Roy MORRIS			
Wilmont Rd. Greenville (mailing address) MS	CLAY	0	30
	SAWD + GRAVEL	30	75
	CLAY	75	
WELL LOCATION:			
sec. 19 T. 17 N. R. 7 E. S. 7			
7 miles SE of Greenville			
(distance) (direction) (nearest town)			
WELL PURPOSE: HOME (home, irrigation, municipal, industrial)			
WELL COMPLETION DATA:			
(1) diameter (inches) 4"			
(2) total depth (feet) 75'			
(3) static water level (feet) 20' below top of ground.			
(4) casing 4" (material), 65' (depth)			
(size) If telescope see back.			
(5) screen 10' (length), 65' (depth to top)			
2" (size), PVC (material)			
(6) pump 1/2 (HP), 10 (yield gpm)			
E.E. (type power)			
(7) electric log XVO (yes or no)			
(organization running log)			
(8) how well bottom plugged b/w			



DRILLERS REMARKS: DS

DEPT. OF NATURAL RESOURCES
BUREAU OF LAND & WATER RESOURCES

JUN - 2 1983

RECEIVED

If well telescopes please sketch and show depths.

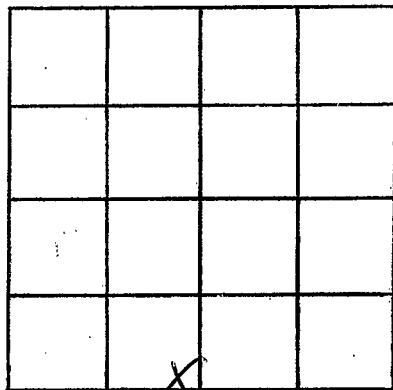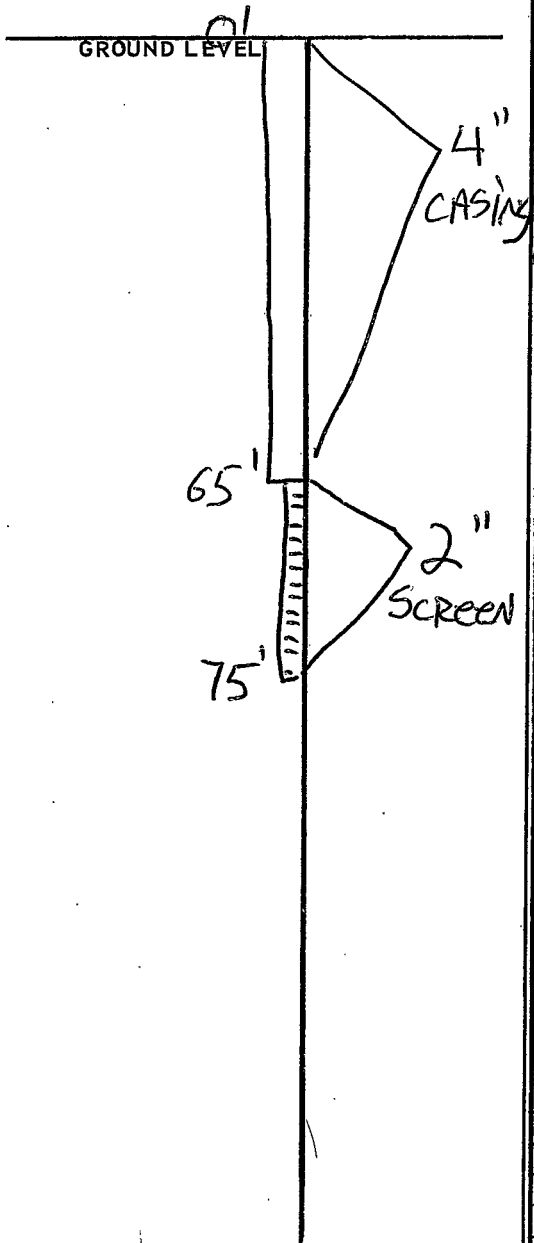

SECTION 19

Please indicate well location X.

ADDITIONAL INFORMATION

If more than one screen, show locations of each on sketch.