

**MISSISSIPPI DEPARTMENT OF NATURAL RESOURCES**  
**Bureau of Land and Water Resources**  
 Southport Mall  
 P.O. Box 10631  
 Jackson, Mississippi 39209  
**WATER WELL DRILLERS LOG**

Washington  
H  
2021


20 June 1983 Lambert Drilling Co. Wash  
 date well completed firm name county well located

LANDOWNER:	description of formations encountered	from	to
<u>Barbra Robinson</u> <u>Greenville, Miss.</u> (mailing address)	<u>Clay</u>	<u>0</u>	<u>40</u>
<b>WELL LOCATION:</b> sec. <u>31</u> T <u>17</u> N R. <u>7</u> E <u>10</u> miles <u>S/E</u> of <u>Greenville</u> (distance) (direction) (nearest town)	<u>Sand.</u>	<u>40</u>	<u>75</u>
<b>WELL PURPOSE:</b> <u>None</u> (home, irrigation, municipal, industrial)	<u>Pea gravel</u>	<u>75</u>	<u>125</u>
<b>WELL COMPLETION DATA:</b>	<u>blue clay</u>	<u>125</u>	<u>210</u>
(1) diameter (inches) <u>2"</u>	<u>Clay st. sand.</u>	<u>210</u>	<u>440</u>
(2) total depth (feet) <u>465</u>	<u>Sand. gravel.</u>	<u>440</u>	<u>465</u>
(3) static water level (feet) <u>32</u> below top of ground.			
(4) casing <u>Pvc.</u> , <u>455'</u> (material) (depth)			
<u>2</u> if telescope see back. (size)			
(5) screen <u>10</u> , <u>465-455'</u> (length) (depth to top)			
<u>2</u> , <u>316 stainless</u> (size) (material)			
(6) pump <u>1</u> , <u>10</u> (HP) (yield gpm)			
<u>elect</u> (type power)			
(7) electric log (yes or no) _____  (organization running log)			
(8) how well bottom plugged, <u>beach press.</u>			
<b>DRILLERS REMARKS:</b>			

DEPT. OF NATURAL RESOURCES  
 BUREAU OF LAND & WATER RESOURCES  
 JUL 15 1983  
**RECEIVED**

If well telescopes please  
sketch and show depths.

GROUND LEVEL

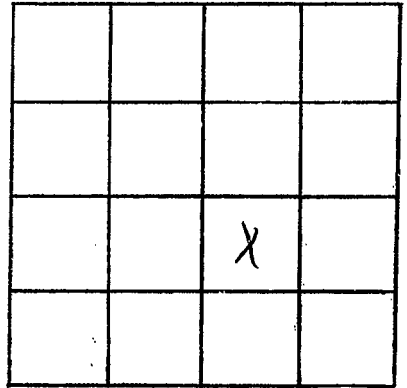

SECTION 31

Please indicate well location X.

ADDITIONAL INFORMATION

If more than one screen,  
show locations of each on sketch.