

MISSISSIPPI DEPARTMENT OF NATURAL RESOURCES

Bureau of Land and Water Resources

Southport Mall

P.O. Box 10631

Jackson, Mississippi 39209

WATER WELL DRILLERS LOG

Washington
H 2022

11-30

1983

Schultz Drilling

Washington

date well completed

firm name

county well located

LANDOWNER: Jim Chavis

Delta Village Park

Greenville MS

(mailing address)

description of formations encountered

from

to

Clay
SAND

0 20

20 40

SAND + pea gravel

40 60

WELL LOCATION:

sec. 10 T 17 N R 7 E
4 miles S of Leland
(distance) (direction) (nearest town)

WELL PURPOSE: Home
(home, irrigation, municipal, industrial)

WELL COMPLETION DATA:

- (1) diameter (inches) 2"
- (2) total depth (feet) 60'
- (3) static water level (feet) 22' below top of ground.
- (4) casing PVC 50'
(material) (depth)
- (size) if telescope see back. N
- (5) screen 10' 50'
(length) (depth to top)
- 2" PVC
(size) (material)
- (6) pump X X
(HP) (yield gpm)
- X
(type power)
- (7) electric log NO
(yes or no)
- X
(organization running log)
- (8) how well bottom plugged PVC CAP


DRILLERS REMARKS:

DEPT. OF NATURAL RESOURCES
BUREAU OF LAND & WATER RESOURCES

RECEIVED
DEC 27 1983

If well telescopes please sketch and show depths.

GROUND LEVEL

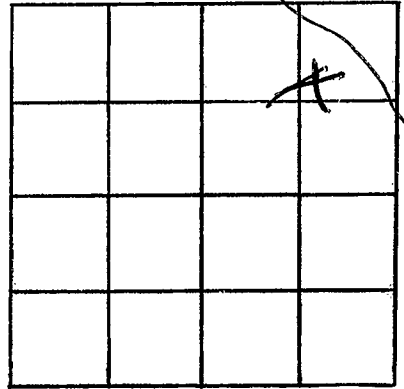

SECTION 10

Please indicate well location X.

ADDITIONAL INFORMATION

If more than one screen,
show locations of each on sketch.