

MISSISSIPPI DEPARTMENT OF NATURAL RESOURCES

Bureau of Land and Water Resources

Southport Mall

P.O. Box 10631

Jackson, Mississippi 39209

WATER WELL DRILLERS LOG

Washington
Hooks

4-28 1984
date well completed

Schultz Drilling
firm name

Washington
county well located

LANDOWNER: Aubrey Hutchinson

1260 Devonshire

Greenville MS.

(mailing address)

description of formations encountered

from

to

CLAY
SAND

0 40
40 76

WELL LOCATION:

sec. 18 T. 17 N. R. 7 E.
6 miles SE of Greenville
(distance) (direction) (nearest town)

WELL PURPOSE: FRIGIDATION
(home, irrigation, municipal, industrial)

WELL COMPLETION DATA:

- (1) diameter (inches) 2"
- (2) total depth (feet) 76'
- (3) static water level (feet) 11' below above top of ground.
- (4) casing PVC 58'
(material) (depth)
2"
(size) if telescope see back.
- (5) screen 20' 56'
(length) (depth to top)
2" stainless steel
(size) (material)
- (6) pump 1 1/2 80
(HP) (yield gpm)
ele
(type power)
- (7) electric log NO
(yes or no)
X
(organization running log)
- (8) how well bottom plugged plug

DEPT. OF NATURAL RESOURCES
BUREAU OF LAND & WATER RESOURCES


APR 24 1984

RECEIVED

DRILLERS REMARKS:

If well telescopes please sketch and show depths.

GROUND LEVEL

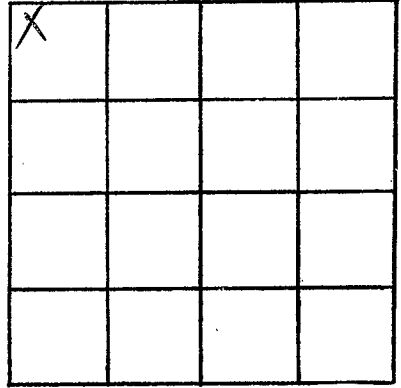

SECTION 18.

Please indicate well location X.

ADDITIONAL INFORMATION

If more than one screen,
show locations of each on sketch.