

MISSISSIPPI DEPARTMENT OF NATURAL RESOURCES

Bureau of Land and Water Resources

Southport Mall

P.O. Box 10631

Jackson, Mississippi 39209

WATER WELL DRILLERS LOG

Washington  
H 2005

9-3  
date well completed

1984 Schultz Drilling  
firm name

Washington  
county well located

| LANDOWNER:  | description of formations encountered | from          | to             |
|---|---------------------------------------|---------------|----------------|
| Doris Reed<br>Greenville, MS<br>(mailing address)   | CLAY<br>MED. SAND<br>COARSE SAND      | 0<br>28<br>50 | 28<br>50<br>80 |
| <b>WELL LOCATION:</b><br>sec. 19 T 17 N R 7 E<br>S S W<br>5 miles S of Greenville<br>(distance) (direction) (nearest town)  |                                       |               |                |
| <b>WELL PURPOSE:</b> Home<br>(home, irrigation, municipal, industrial)  |                                       |               |                |
| <b>WELL COMPLETION DATA:</b><br>(1) diameter (inches) 2"<br>(2) total depth (feet) 80'<br>(3) static water level (feet) 24' below top of ground.<br>(4) casing PVC 75'<br>(material) (depth)<br>(size) If telescope see back.<br>(5) screen 5' 75'<br>(length) (depth to top)<br>2" PVC<br>(size) (material)<br>(6) pump <input checked="" type="checkbox"/> <input checked="" type="checkbox"/><br>(HP) (yield gpm)<br><input checked="" type="checkbox"/><br>(type power)<br>(7) electric log No<br>(yes or no)<br>(organization running log)<br>(8) how well bottom plugged PVC CAP. |                                       |               |                |
| <b>DRILLERS REMARKS:</b>  |                                       |               |                |


DEPT. OF NATURAL RESOURCES  
BUREAU OF LAND & WATER RESOURCES

NOV 26 1984

RECEIVED

If well telescopes please sketch and show depths.

GROUND LEVEL

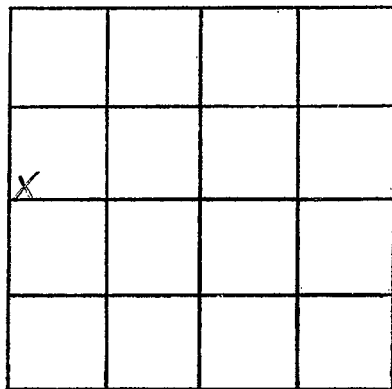

SECTION 19

Please indicate well location X.

ADDITIONAL INFORMATION

If more than one screen,  
show locations of each on sketch.