

MISSISSIPPI DEPARTMENT OF NATURAL RESOURCES

Bureau of Land and Water Resources

Southport Mall

P.O. Box 10631

Jackson, Mississippi 39209

WATER WELL DRILLERS LOG

WASHINGTON
A
2027


2-18 1986 Scholtz Drilling WASHINGTON
date well completed firm name county well located

LANDOWNER: JACK TAYLOR Rt 2	description of formations encountered	from	to
Greenville, MS (mailing address)	CLAY	0	15
	SAND + PEA gravel	15	75
	CLAY	75	225
	SHALE	225	260
	FINE SAND	260	330
	MED SAND	330	390
	CLAY	390	420
	SAND	420	465
WELL LOCATION: sec. 7 T 17 N R 2 E 5 miles SE of Greenville (distance) (direction) (nearest town)			
WELL PURPOSE: HOME (home, irrigation, municipal, industrial)			
WELL COMPLETION DATA:			
(1) diameter (inches) 2"			
(2) total depth (feet) 450'			
(3) static water level (feet) 21' below top of ground.			
(4) casing PVC 440' (material) (depth)			
if telescope see back. (size)			
(5) screen 10' 440' (length) (depth to top)			
2" PVC (size) (material)			
(6) pump 1 10 (HP) (yield gpm)			
ele (type power)			
(7) electric log NO (yes or no)			
X (organization running log)			
(8) how well bottom plugged b/w			
DRILLERS REMARKS:			

REGISTERED
MAR 1 8 1986
Department of Natural Resources
BUREAU OF LAND & WATER RESOURCES

If well telescopes please sketch and show depths.

GROUND LEVEL

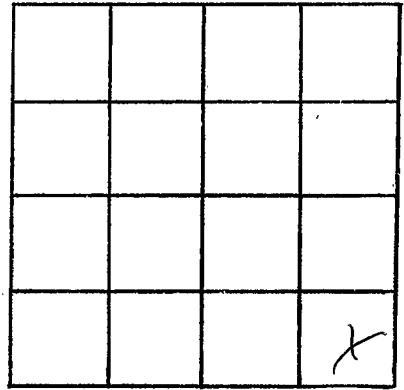

SECTION 7

Please indicate well location X.

ADDITIONAL INFORMATION

If more than one screen,
show locations of each on sketch.