

MISSISSIPPI DEPARTMENT OF NATURAL RESOURCES

Bureau of Land and Water Resources

Southport Mall

P.O. Box 10631

Jackson, Mississippi 39209

WATER WELL DRILLERS LOG

WASHINGTON
W
2028

4-18-86 date well completed Schultz Drilling firm name Washington county well located


LANDOWNER: <u>US Forestry</u> <u>Wilmont Rd</u> <u>Greenville MS</u> (mailing address)	description of formations encountered	from	to
WELL LOCATION: sec. <u>22</u> T. <u>17</u> N. R. <u>7</u> E <u>7</u> miles S of <u>Leland</u> (distance) (direction) (nearest town)			
WELL PURPOSE: <u>HOME</u> (home, irrigation, municipal, industrial)			
WELL COMPLETION DATA:			
(1) diameter (inches) <u>2"</u>			
(2) total depth (feet) <u>68'</u>			
(3) static water level (feet) <u>29'</u> below top of ground.			
(4) casing <u>galv.</u> <u>63'</u> (material) (depth)			
(size) if telescope see back.			
(5) screen <u>5'</u> <u>63'</u> (length) (depth to top)			
<u>2"</u> <u>stainless</u> (size) (material)			
(6) pump <u>1</u> <u>10</u> (HP) (yield gpm)			
<u>ele</u> (type power)			
(7) electric log <u>NO</u> (yes or no)			
<u>X</u> (organization running log)			
(8) how well bottom plugged <u>CAP</u>			
DRILLERS REMARKS:			

RECEIVED
MAY 20 1986

Department of Natural Resources
Bureau of Land and Water Resources

If well telescopes please sketch and show depths.

GROUND LEVEL

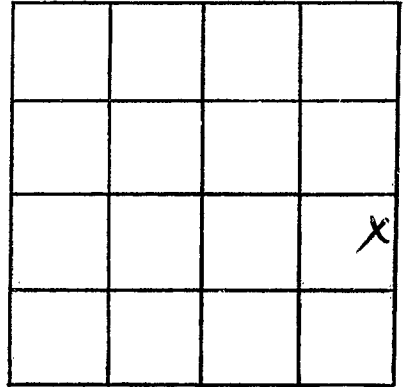

SECTION 22

Please indicate well location X.

ADDITIONAL INFORMATION

If more than one screen,
show locations of each on sketch.