

MISSISSIPPI DEPARTMENT OF NATURAL RESOURCES

Bureau of Land and Water Resources

Southport Mall

P.O. Box 10631

Jackson, Mississippi 39209

WATER WELL DRILLERS LOG

WASHINGTON
H 2027

8-21 1986 Schultz Drilling WASHINGTON
date well completed firm name county well located

LANDOWNER:
LEROY WATSON Rt. 2
Greenville, MS
(mailing address)

description of formations encountered	from	to
CLAY	0	25
SAND	25	60
SAND + PEA GRAVEL	60	75

WELL LOCATION:
sec. 32-17(N) R. 2 E
3 miles W of Arcola
(distance) (direction) (nearest town)

WELL PURPOSE: HOME
(home, irrigation, municipal, industrial)

- WELL COMPLETION DATA:
- (1) diameter (inches) 2"
 - (2) total depth (feet) 75'
 - (3) static water level (feet) 29' below above top of ground.
 - (4) casing PVC 70' (material) (depth)
 - (size) if telescope see back.
 - (5) screen 5' 70' (length) (depth to top)
2" PVC (size) (material)
 - (6) pump 1 10 (HP) (yield gpm)
ele (type power)
 - (7) electric log no (yes or no)
X (organization running log)
 - (8) how well bottom plugged b/w


RECEIVED
OCT 01 1986

Department of Natural Resources
Bureau of Land & Water Resources

DRILLERS REMARKS:

If well telescopes please sketch and show depths.

GROUND LEVEL

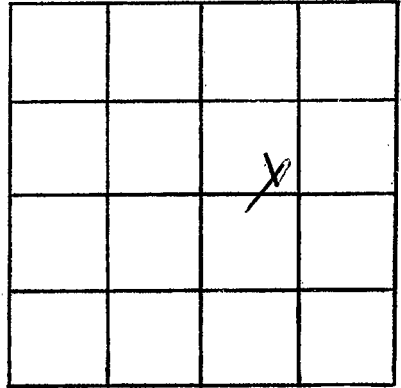

SECTION

32

Please indicate well location X.

ADDITIONAL INFORMATION

If more than one screen, show locations of each on sketch.