

MISSISSIPPI DEPARTMENT OF NATURAL RESOURCES

Bureau of Land and Water Resources

Southport Mall

P.O. Box 10631

Jackson, Mississippi 39209

WATER WELL DRILLERS LOG

WASHINGTON
HARRIS

5-23-86
date well completed

Schultz Drilling
firm name

WASHINGTON
county well located

LANDOWNER:
FARM Fresh Catfish
Hollandale, MS
(mailing address)


description of formations encountered	depth	
	from	to
CLAY	0	35
SAND	35	75
CLAY	75	440
SAND	440	480

WELL LOCATION:
sec. 34 T. 17 N. R. 2 E
2 miles W of Arcola
(distance) (direction) (nearest town)

WELL PURPOSE: Home
(home, irrigation, municipal, industrial)

- WELL COMPLETION DATA:
- (1) diameter (inches) 2"
 - (2) total depth (feet) 480'
 - (3) static water level (feet) 29' below top of ground.
 - (4) casing PVC 470'
(material) (depth)
 - (5) screen 10' 470'
(length) (depth to top)
2" PVC
(size) (material)
 - (6) pump 10
(HP) (yield gpm)
ele.
(type power)
 - (7) electric log no
(yes or no)
K
(organization running log) b/w
 - (8) how well bottom plugged


DRILLERS REMARKS:

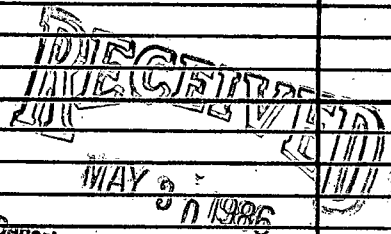

Department of Natural Resources
Bureau of Land & Water Resources

If well telescopes please sketch and show depths.

GROUND LEVEL

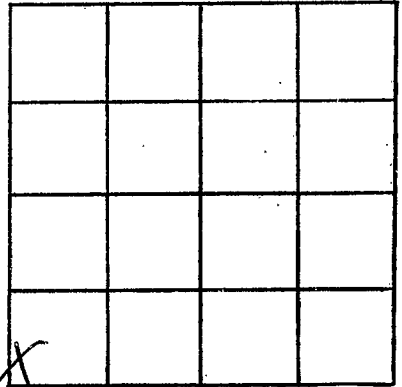

SECTION 34

Please indicate well location X.

ADDITIONAL INFORMATION

If more than one screen, show locations of each on sketch.