

MISSISSIPPI DEPARTMENT OF NATURAL RESOURCES

Bureau of Land and Water Resources

Southport Mall

P.O. Box 10631

Jackson, Mississippi 39209

WATER WELL DRILLERS LOG

WASHINGTON  
H 2031

17 June 1986 Lambert Drilling Wash  
date well completed firm name county well located

LANDOWNER:	description of formations encountered	from	to
(mailing address)			
Mrs. B. Stott Leland, Miss.	m. x. c.	0	15
WELL LOCATION:	sand	0	70
sec. 24 T 17 N S R 7 E W	pea gravel	70	140
8 miles S of Leland	clay	140	195
(distance) (direction) (nearest town)	sand	195	240
WELL PURPOSE: none	sand gravel	240	330
(home, irrigation, municipal, industrial)			
WELL COMPLETION DATA:			
(1) diameter (inches) 4 1/2			
(2) total depth (feet) 330			
(3) static water level (feet) 24 below top of ground.			
(4) casing PVC 86 (material) (depth)			
4 1/2 (size) if telescope see back.			
(5) screen 30 330-300 (length) (depth to top)			
2" (size) PVC (material)			
(6) pump 1 20 (HP) (yield gpm)			
elec. (type power)			
(7) electric log (yes or no)			
(organization running log)			
(8) how well bottom plugged none back ports			
DRILLERS REMARKS:			

RECEIVED  
BUREAU OF LAND & WATER RESOURCES  
JUL 08 1986

Department of Natural Resources  
Bureau of Land & Water Resources


If well telescopes please sketch and show depths.

GROUND LEVEL

4" 140

2" 300

2" 50" 376

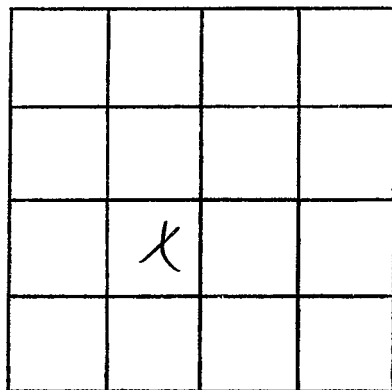

SECTION 24

Please indicate well location X.

ADDITIONAL INFORMATION

If more than one screen, show locations of each on sketch.