

WASHINGTON  
H 2032

MISSISSIPPI DEPARTMENT OF NATURAL RESOURCES  
Bureau of Land and Water Resources  
Southport Mall  
P.O. Box 10631  
Jackson, Mississippi 39209  
WATER WELL DRILLERS LOG

12-5 1986 date well completed Schultz Drilling firm name Washington county well located

LANDOWNER: Alfred Hernandez  
Sligo Rd.  
Greenville, MS  
(mailing address)

description of formations encountered	depth	
	from	to
CLAY	0	18
COARSE SAND	18	88
Shale	88	360
SAND	360	435

WELL LOCATION:  
sec. 17 T 17 N R 7 E  
4 miles SE of Greenville  
(distance) (direction) (nearest town)

WELL PURPOSE: HOME  
(home, irrigation, municipal, industrial)

- WELL COMPLETION DATA:
- (1) diameter (inches) 2"
  - (2) total depth (feet) 435'
  - (3) static water level (feet) 27' below top of ground
  - (4) casing PVC 425'  
(material) (depth)  
If telescope see back.  
(size)
  - (5) screen 10' 425'  
(length) (depth to top)  
2" PVC  
(size) (material)
  - (6) pump 1 10  
(HP) (yield gpm)  
ele  
(type power)
  - (7) electric log NO  
(yes or no)  
K  
(organization running log)
  - (8) how well bottom plugged b/w

RECEIVED


FEB 06 1987

Department of Natural Resources  
Bureau of Land & Water Resources

DRILLERS REMARKS:

If well telescopes please  
sketch and show depths.

GROUND LEVEL

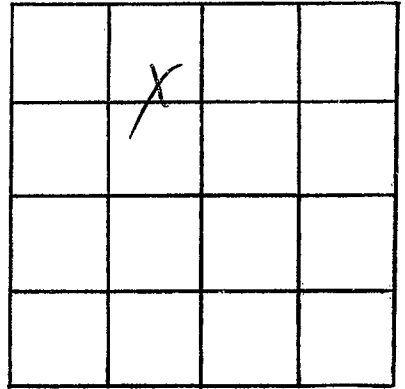

SECTION 19

Please indicate well location X.

ADDITIONAL INFORMATION

If more than one screen,  
show locations of each on sketch.