

Washington
H 2034

MISSISSIPPI DEPARTMENT OF NATURAL RESOURCES
Bureau of Land and Water Resources
Southport Mall
P.O. Box 10631
Jackson, Mississippi 39209
WATER WELL DRILLERS LOG

3-28 19 87 date well completed
Schultz Drilling firm name
Washington county well located

LANDOWNER: AQUA FARMS
Wilmot Rd.
Greenville, MS
(mailing address)

WELL LOCATION:
sec. 20 T 17 N R 7 E
5 miles SE of Greenville
(distance) (direction) (nearest town)

WELL PURPOSE: HOME
(home, irrigation, municipal, industrial)

- WELL COMPLETION DATA:
- (1) diameter (inches) 4" x 3"
 - (2) total depth (feet) 520'
 - (3) static water level (feet) 32' below top of ground.
 - (4) casing PUC 490'
(material) (depth)
If telescope see back.
(size) 30' 490'
(5) screen (length) (depth to top)
3' PUC
(size) (material)
(6) pump 3 50
(HP) (yield gpm)
ele
(type power)
(7) electric log NO
(yes or no)
X
(organization running log)
(8) how well bottom plugged b/w

description of formations encountered	depth	
	from	to
CLAY	0	25
SAND	25	80
CLAY	80	440
ROCK	440	442
CLAY	442	460
SAND	460	540



RECEIVED

JUL 3 1987

Department of Natural Resources
Bureau of Land & Water Resources

DRILLERS REMARKS:

If well telescopes please sketch and show depths.

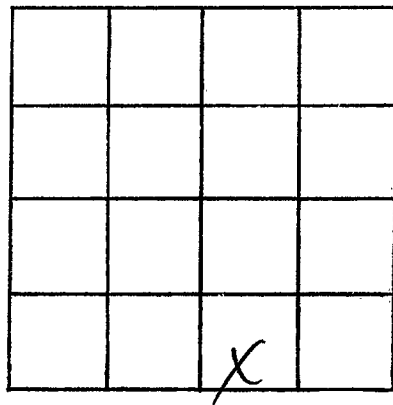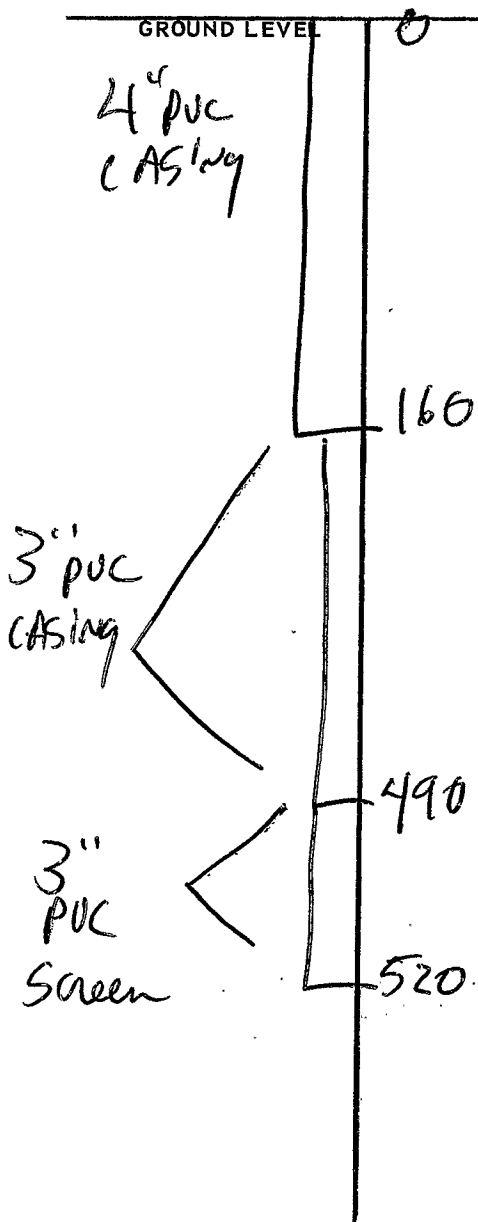

SECTION 20

Please indicate well location X.

ADDITIONAL INFORMATION

Lined area for additional information.

If more than one screen, show locations of each on sketch.