

Washington
H 2035

MISSISSIPPI DEPARTMENT OF NATURAL RESOURCES
Bureau of Land and Water Resources
Southport Mall
P.O. Box 10631
Jackson, Mississippi 39209
WATER WELL DRILLERS LOG

4-22 1987 Schultz Drilling Washington
date well completed firm name county well located


LANDOWNER: Roy Morris
Wilmot Rd
Greenville MS
(mailing address)

description of formations encountered	from	to
CLAY	0	15
SAND	15	90
CLAY	90	345
SHALE	345	380
SAND	380	420

WELL LOCATION:
sec 19 T 17 N R 2 E
5 miles SE of Greenville
(distance) (direction) (nearest town)

WELL PURPOSE: Home
(home, irrigation, municipal, industrial)

- WELL COMPLETION DATA:
- (1) diameter (inches) 4" x 2"
 - (2) total depth (feet) 420
 - (3) static water level (feet) 32' below top of ground.
 - (4) casing PUC 400' (material) (depth)
 - (size) If telescope see back.
 - (5) screen 20' 400' (length) (depth to top)
2" PUC (size) (material)
 - (6) pump 1 20 (HP) (yield gpm)
ele (type power)
 - (7) electric log NO (yes or no)
K (organization running log)
 - (8) how well bottom plugged clay

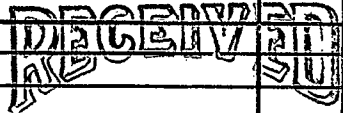

JUL 3 1987

Department of Natural Resources
Bureau of Land & Water Resources

DRILLERS REMARKS:

