

MISSISSIPPI DEPARTMENT OF NATURAL RESOURCES

Bureau of Land and Water Resources

Southport Mall

P.O. Box 10631

Jackson, Mississippi 39209

WATER WELL DRILLERS LOG

19 mar 19 87  
date well completed

Lambert Drilling  
firm name

Wash  
county well located

LANDOWNER:  
RJ Stott  
Arcola, Miss.  
(mailing address)

WELL LOCATION:  
sec. 24 T. 17 N. R. 2 E  
3 miles N/E of Arcola  
(distance) (direction) (nearest town)

WELL PURPOSE: private  
(home, irrigation, municipal, industrial)

WELL COMPLETION DATA:  
(1) diameter (inches) 4 1/2  
(2) total depth (feet) 320  
(3) static water level (feet) 46 below above top of ground.  
(4) casing PVC, 290,  
(material) (depth)  
4 1/2 if telescope see back.  
(size)  
(5) screen 30, 320-290  
(length) (depth to top)  
2", PVC  
(size) (material)  
(6) pump 1, 20  
(HP) (yield gpm)  
elect  
(type power)  
(7) electric log no.  
(yes or no)  
(organization running log)  
(8) how well bottom plugged  
brick pits

description of formations encountered	from	to
Mixed	0	20
Sand	20	60
fine gravel	60	136
Clay	136	226
Sand Fine	226	260
Sand	260	320

RECEIVED

OCT 29 1987

Department of Natural Resources  
Bureau of Land & Water Resources

DRILLERS REMARKS:


If well telescopes please sketch and show depths.

GROUND LEVEL

140 4"

290 2 1/2"

320 2 1/2"

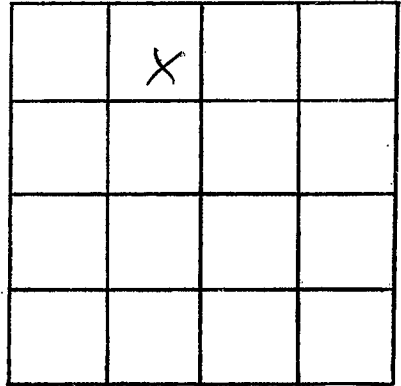

SECTION 24

Please indicate well location X.

ADDITIONAL INFORMATION

If more than one screen, show locations of each on sketch.