

WASHINGTON  
H 2037

MISSISSIPPI DEPARTMENT OF NATURAL RESOURCES

Bureau of Land and Water Resources

Southport Mall

P.O. Box 10631

Jackson, Mississippi 39209

WATER WELL DRILLERS LOG

1-28 1988  
date well completed

Schultz Drilling  
firm name

Washington  
county well located

LANDOWNER: DAVID COUNTS  
Sligo ROAD  
Greenville, MS  
(mailing address)

description of formations encountered	from	to
	CLAY	0
SAND	16	88
CLAY	88	150
SHALE	150	350
SAND	350	400

WELL LOCATION:  
sec. 19 T 17 N R 7 E  
3 miles SE of Greenville  
(distance) (direction) (nearest town)

WELL PURPOSE: Home  
(home, irrigation, municipal, industrial)

WELL COMPLETION DATA:

- (1) diameter (inches) 2"
- (2) total depth (feet) 400'
- (3) static water level (feet) 32' below top of ground.
- (4) casing PVC 390'  
(material) (depth)
- \_\_\_\_\_ If telescope see back.  
(size)
- (5) screen 10' 390'  
(length) (depth to top)
- 2" PVC  
(size) (material)
- (6) pump 1 10  
(HP) (yield gpm)
- E/E.  
(type power)
- (7) electric log NO  
(yes or no)
- X  
(organization running log)
- (8) how well bottom plugged b/w

RECEIVED


MAR 11 1988

Department of Natural Resources  
Bureau of Land & Water Resources

DRILLERS REMARKS:

If well telescopes please sketch and show depths.

GROUND LEVEL

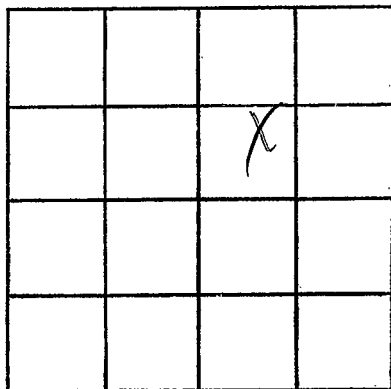

SECTION 19

Please indicate well location X.

ADDITIONAL INFORMATION

If more than one screen, show locations of each on sketch.