

**MISSISSIPPI DEPARTMENT OF ENVIRONMENTAL QUALITY**

Office of Land and Water Resources

P. O. Box 10631  
Jackson, MS 39289-0631  
**WATER WELL DRILLERS LOG**

COUNTY WELL LOCATED <u>Washington</u>	
WELL NUMBER <u>H</u>	CODED
DATE WELL COMPLETED <u>2008 6-14-94</u>	

PERMIT NUMBER
NAME OF DRILLING FIRM <u>Schudco, Ltd.</u>

NAME & MAILING ADDRESS OF LANDOWNER <u>Martin McDonald</u> <u>Lehalzd Ms</u> <u>38756</u>		
WELL LOCATION: SEC	TOWNSHIP	RANGE
<u>6</u>	<u>17</u>	<u>7</u>
DISTANCE	DIRECTION	NEAREST TOWN
<u>2 1/2</u> Miles	<u>west</u>	<u>Burdett</u>
OTHER LANDMARK		
WELL PURPOSE: Home <u>Irrigation</u> Municipal, Industrial, Fish Pond, etc.		

PUMP DATA		
PUMP TYPE (Circle One): Submersible, <u>Turbine</u> Jet Flowing Well, Other (Describe) _____		
POWER TYPE (Circle One): Electric, Tractor, Diesel, Gasoline, Butane, Other (Describe) _____ H/P _____		
Pump Capacity (GPM)	No. of Stages	Setting Depth
		FT.
PUMP TEST		
Well yielded _____ GPM with a drawdown of _____ ft. after _____ hours of pumping		

WELL DATA		
Well Depth <u>70</u>	Casing Diameter (in.) <u>12</u>	Casing Length (Ft.) <u>50</u>
Type of Casing <u>PVC</u>	Hole Depth <u>71</u>	Depth to Static Water Level <u>26</u>
TYPE OF COMPLETION: (Circle One or More): <u>Gravel Packed</u> , Underreamed, Telescoped, Natural Development, Open Hole, Other		

LOG DATA	
TYPE OF LOG RUN (Circle One): Electric, Gamma Ray, Density, Sonic, <u>No Log Run</u> , Neutron, Other (Describe) _____	
Name of Organization Running Log	

WELL GROUTED TO A DEPTH OF 10 FEET  
Type Grout (circle one): Cement, Bentonite, or Mix

GEOLOGIC DATA (Office Use Only)			
Surface Elev.	Geologic Unit	Unit Thickness	Depth to Top
Subs. SWL	Date	Analysis	Aquifer Test

SCREEN DATA		
Diameter - Inches <u>12</u>	Length - Feet <u>20</u>	Slot Size - Inches <u>.032</u>
Screen Type <u>PVC</u>	Depth to Bottom - Feet <u>75</u>	


Driller's Remarks

DESCRIPTION OF FORMATIONS ENCOUNTERED	FROM	TO
<u>Clay</u>	<u>0</u>	<u>10</u>
<u>Sand &amp; gravel</u>	<u>10</u>	<u>70</u>
<u>clay</u>	<u>70</u>	<u>71</u>

FORMATIONS (Continued)	FROM	TO
<b>RECEIVED</b>		
<b>AUG 16 1994</b>		
Dept. of Environmental Quality Office of Land & Water Resources		
IF MORE SPACE IS NEEDED, USE BACK		

If well telescopes please sketch and show depths.

GROUND LEVEL

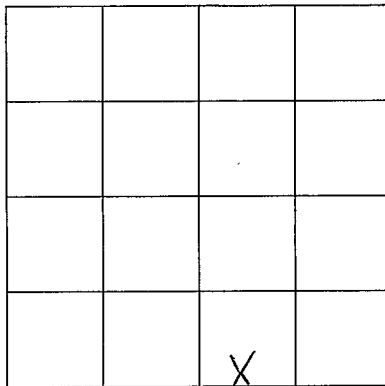

SECTION 6

Please indicate well location X.

ADDITIONAL INFORMATION

If more than one screen,  
show location of each on sketch.