

MISSISSIPPI DEPARTMENT OF ENVIRONMENTAL QUALITY

Office of Land and Water Resources

P. O. Box 10631
Jackson, MS 39289-0631
WATER WELL DRILLERS LOG

COUNTY WELL LOCATED <u>Washington</u>	
WELL NUMBER <u>7</u>	CODED <u>2075</u>
DATE WELL COMPLETED <u>4-19-97</u>	

PERMIT NUMBER
NAME OF DRILLING FIRM <u>Schudde Ltd</u>

NAME & MAILING ADDRESS OF LANDOWNER <u>Bland Payton O'HARE FARMS P.O. Box 185</u>		
<u>HOLLANDALE MS 38748</u>		
WELL LOCATION: SEC	TOWNSHIP	RANGE
<u>24</u>	<u>17</u>	<u>N 7 E</u>
DISTANCE	DIRECTION	NEAREST TOWN
<u>2 1/2</u> Miles	<u>North</u> of	<u>Arcock</u>
OTHER LANDMARK		
WELL PURPOSE: Home <u>Irrigation</u> Municipal, Industrial, Fish Pond, etc.		

PUMP DATA		
PUMP TYPE (Circle One): Submersible, <u>Turbine</u> Jet Flowing Well, Other (Describe)		
POWER TYPE (Circle One): Electric, <u>Tractor</u> Diesel, Gasoline, Butane, Other (Describe) H/P <u>160</u>		
Pump Capacity (GPM) <u>2000</u>	No. of Stages <u>1</u>	Setting Depth <u>5</u> FT.
PUMP TEST Well yielded _____ GPM with a drawdown of _____ ft. after _____ hours of pumping		

WELL DATA		
Well Depth <u>110</u>	Casing Diameter (In.) <u>16</u>	Casing Length (Fl.) <u>70</u>
Type of Casing <u>pvc</u>	Hole Depth <u>110</u>	Depth to Static Water Level <u>24 ft</u>

LOG DATA	
TYPE OF LOG RUN (Circle One): Electric, Gamma Ray, Density, Sonic, <u>No Log Run</u> , Other (Describe) Neutron,	
Name of Organization Running Log	

TYPE OF COMPLETION: (Circle One or More):
Gravel Packed, Underreamed, Telescoped,
Natural Development, Open Hole, Other

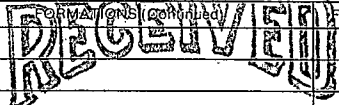
GEOLOGIC DATA (Office Use Only)			
Surface Elev.	Geologic Unit	Unit Thickness	Depth to Top
Subs. SWL	Date	Analysis	Aquifer Test

WELL GROUTED TO A DEPTH OF _____ FEET
Type Grout (circle one): Cement, Bentonite, or Mix

Driller's Remarks

SCREEN DATA		
Diameter - Inches <u>16</u>	Length - Feet <u>40</u>	Slot Size - Inches <u>.032</u>
Screen Type <u>pvc</u>	Depth to Bottom - Feet <u>110</u>	

DESCRIPTION OF FORMATIONS ENCOUNTERED	FROM	TO
<u>Top soil</u>	<u>0</u>	<u>10</u>
<u>clay</u>	<u>10</u>	<u>22</u>
<u>med sand</u>	<u>22</u>	<u>70</u>
<u>med to coarse some PG</u>	<u>70</u>	<u>110</u>


MAY 09 1997
 Dept. of Environmental Quality
 Office of Land & Water Resources

IF MORE SPACE IS NEEDED, USE BACK

If well telescopes please sketch and show depths.

GROUND LEVEL

			X

SECTION 24

Please indicate well location X.

ADDITIONAL INFORMATION

If more than one screen,
show location of each on sketch.