

WASH.

MISSISSIPPI BOARD OF WATER COMMISSIONERS

# 10  
6-11-62

WATER WELL DRILLERS LOG

(P/118)

CODED

Date: 6/11, 1962, Driller: Bailey Drilling Co. (Name) County: Washington

(1) Owner of Land: S.C. Dulaney  
(Name)  
Leland, Miss.  
(Address)

(2) Location: 17N 7W T R  
6 miles South, of Leland  
(distance) (direction) (Nearest Town)

(3) Topography: Flat  
(Hilly) (Flat) (Level)

(4) Purpose of Well: domestic  
(Domestic Irrigation  
Municipal, Industrial, Other)

Description & Color of Materials Sand, Clay, Red Clay, Shell, etc.	Thick- ness Feet	Depth Feet
Clay	28	28
Sand	42	70
Gravel + Sand	105	175
Mud	95	270
Sand + Mud	20	290
Sand	69	359
Rock	1	360
Mud	2	362
Sand	10	372
Hard pan	2	374
Sand	46	420

Information upon completion of well:

(1) Diameter 4 x 2 1/2 inches.

(2) Total Depth 420 feet.

(3) Water Level 21 feet below top of ground.

(4) Cased to 4 x 2 1/2, Size all way

(5) Screen: Size 2 1/2, Length 30 ft

(6) Were any formations sealed against pollution?  
 \_\_\_\_\_ yes, X no.

CODED


If YES, depth of formation \_\_\_\_\_

Why \_\_\_\_\_

Drillers Remarks: \_\_\_\_\_

\_\_\_\_\_

\_\_\_\_\_

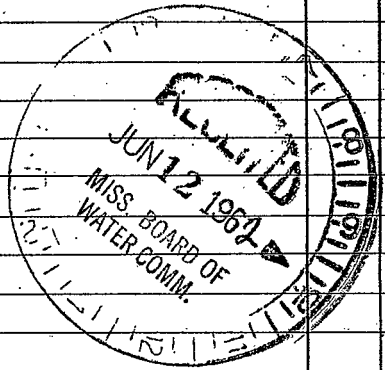

(Use Back Side)

Well No.

[The text in this image is extremely faint and illegible. It appears to be a multi-paragraph document, possibly a letter or a report, but the specific words and sentences cannot be discerned. The text is scattered across the page with some faint lines of what might be a list or table on the left side.]