

WASH.

MISSISSIPPI BOARD OF WATER COMMISSIONERS

J/14

7-31-63

WATER WELL DRILLERS LOG

CODED

Date: July 31, 1963, Driller: DELTA DRILLING Co. County WASHINGTON

(Name)

JOHN & CAMERON DEAN

(1) Owner of Land: DEAN & Co.

DEAN DALE ^(Name) HEAD QUARTERS -

BEHAND, MISS.
(Address)

(2) Location: NW 1/4, NW 1/4, Sec. 14 T17R6

 miles , of
(distance) (direction) (Nearest Town)

(3) Topography:
(Hilly) (Flat) (Level)

(4) Purpose of Well: DOMESTIC -
(Domestic Irrigation
Municipal, Industrial, Other)

Description & Color of Materials Sand, Clay, Red Clay, Shell, etc.	Thick- ness Feet	Depth Feet
GUMBO	8	8
SAND	90	98
GRAVEL	33	131
GUMBO	50	181
SHALE	62	243
GUMBO	40	283
SHALE	38	321
GUMBO	30	351
SAND	52	403
SHALE	29	432

Information upon completion of well:


- (1) Diameter 4 inches.
- (2) Total Depth 432 feet.
- (3) Water Level 19 feet below top of ground.
- (4) Cased to 422, Size 116" - 4" 306" - 2 1/2"
- (5) Screen: Size 2 1/2", Length 10'
- (6) Were any formations sealed against pollution?
 yes, no.

CODED

*Insuff. info
to locate*

If YES depth of formation
Why

Drillers Remarks: 50-70 RED JACKET
DEEP WELL SUBMERSIBLE PUMP
SET 63' IN WELL W/ 1 1/2" PIPE
AND 315 GAL BLK STEEL
PRESSURE TANK - 34" - 2 1/2"
TAIL PIPE ON BOTTOM END
OF WELL

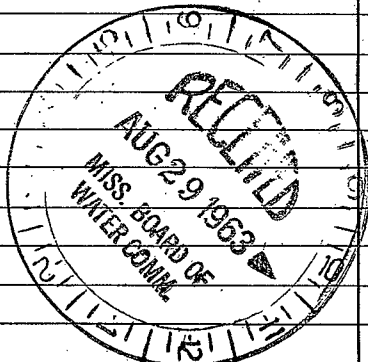

(Use Back Side)

Well No.

1000
1000

