

J 15
8-12-63

WATER WELL DRILLERS LOG

Date: 8-12, 1963, Drillers: DELTA DRILLING Co County WASHINGTON
(Name)

(1) Owner of Land: DEAN & Co
FAITH PLANTATION
(Name)
TRIBBETT, MISS-
(Address)

(2) Location: SW 1/4, NW 1/4, Sec. 23 T17R6W
_____ miles _____ of _____
(distance) (direction) (Nearest Town)

(3) Topography: _____
(Hilly) (Flat) (Level)

(4) Purpose of Well: DOMESTIC
(Domestic Irrigation
Municipal, Industrial, Other)

Description & Color of Materials Sand, Clay, Red Clay, Shell, etc.	Thick- ness Feet	Depth Feet
GUMBO	16	16
SAND	90	106
GRAVEL	21	127
GUMBO	110	237
SHALE	41	278
GUMBO	60	338
SHALE	50	388
FINE SAND	22	410
SHALE	180	590
FINE SAND	48	638
WHITE SAND	22	660
SHALE	15	675

Information upon completion of well:

(1) Diameter 4 inches.


(2) Total Depth 675 feet.

(3) Water Level 16' feet below top of ground.

(4) Cased to 652, Size 4" 100'
2 1/2" 565'

(5) Screen: Size 2 1/2", Length 10' SS

(6) Were any formations sealed against pollution?
_____ yes, _____ no.

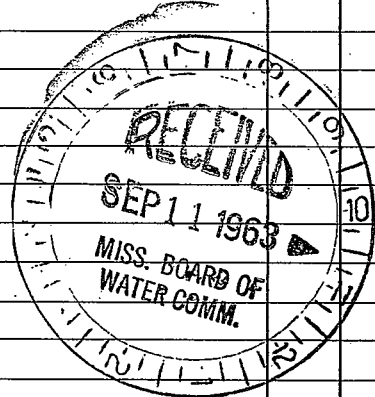

If YES depth of formation _____
Why _____

Drillers Remarks: 13'-2 1/2" TAIL PIPE
ON BOTTOM OF WELL - PUMP
SET 63' IN WELL W/ 1 1/2" PIPE

EE-log # 46

(Use Back Side)

Well No.

