

WASH.

MISSISSIPPI BOARD OF WATER COMMISSIONERS

F

8/19

12-26-61

WATER WELL DRILLERS LOG

Date: 12/26, 1961, Driller: Bailey Drilling Co. County: Washington

CODED

(Name)

- (1) Owner of Land: SC Sulaney
(Name)
Leland, Miss.
(Address)
- (2) Location: 1/4, 1/4, Sec. 7 T N R 6W
5 miles SE of Leland
(distance) (direction) (Nearest Town)
- (3) Topography: Flat
(Hilly) (Flat) (Level)
- (4) Purpose of Well: domestic
(Domestic Irrigation
Municipal, Industrial, Other)

Description & Color of Materials
Sand, Clay, Red Clay, Shell, etc.

Thick-
ness
Feet


Depth
Feet

| | | |
|---------------|-----|-----|
| Clay | 12 | 12 |
| Mud | 38 | 50 |
| Sand + gravel | 65 | 115 |
| Sand | 122 | 237 |
| Mud | 188 | 425 |
| Sand | 25 | 450 |

Information upon completion of well:

- (1) Diameter 3X2 inches.
- (2) Total Depth 450 feet.
- (3) Water Level 18 feet below top of ground.
- (4) Cased to all way, Size 3X2
- (5) Screen: Size 2", Length 20 ft
- (6) Were any formations sealed against pollution?
no

CODED

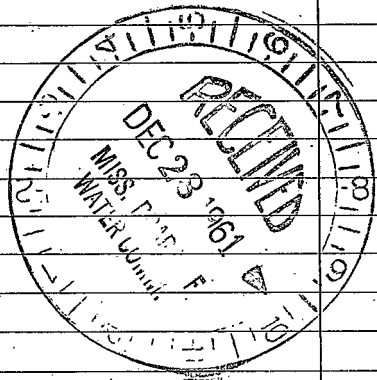

Insuff. info to locate

If YES depth of formation
Why
Drillers Remarks:

(Use Back Side)

Well No.

