

WASH.
J 23
1-29-62

MISSISSIPPI BOARD OF WATER COMMISSIONERS

J 10

WATER WELL DRILLERS LOG

Jones 1232

Date: Jan. 29, 19 62, Driller: Layne-Central Company County Washington

(Name)

(1) Owner of Land: R. M. Pritchett
(Name)

Arcola, Mississippi
(Address)

(2) Location: 1/4, 1/4, Sec. 31? T17N R6W

1 miles east of Arcola
(distance) (direction) (Nearest Town)

(3) Topography: flat
(Hilly) (Flat) (Level)

(4) Purpose of Well: domestic
(Domestic Irrigation
Municipal, Industrial, Other)


Description & Color of Materials Sand, Clay, Red Clay, Shell, etc.	Thick- ness Feet	Depth Feet
Sandy clay	23	23
Fine sand	42	65
Coarse sand	15	80
Coarse sand & pea gravel	70	150
Sandy clay	15	165
Blue clay	26	191
Clay & sandy clay strks.	39	230
Sandy clay	23	253
Clay	17	270
Clay & sandy clay strks.	32	302
Fine sand	58	360
Fine sand & clay strks.	56	416
Sand	30	445
Clay & fine sand strks.	26	471

Information upon completion of well:

- (1) Diameter 4x3 inches.
- (2) Total Depth 449'-9" feet.
- (3) Water Level 16' feet below top of ground.
- (4) Cased to 310'-5", Size 3"
105', Size 4"
- (5) Screen: Size 30'-5", Length 3"
3'-3" of 3" B.P.V.
- (6) Were any formations sealed against pollution?
yes yes, no no.

If YES depth of formation packer above
the screen.
Why _____

Drillers Remarks: 50 lbs. shot on top
of B.P.V. 25 lbs. shot fills up
13 1/2" - 3" pipe.

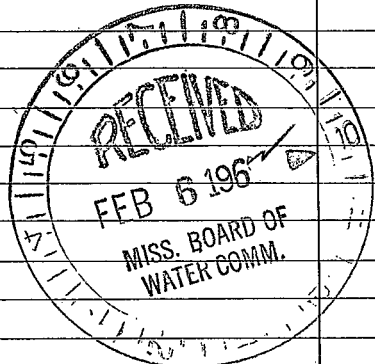

(Use Back Side)

Retain this copy for your office files.

Well No.

[The page contains extremely faint and illegible text, likely bleed-through from the reverse side of the document. The text is too light to transcribe accurately.]