

Washington  
J 25  
11-67

MISSISSIPPI  
 BOARD OF WATER COMMISSIONERS  
 416 North State Street  
 Jackson, Mississippi 39201

WATER WELL DRILLERS LOG

11/7 1967 Bailey Drly Co. Washington  
 date well completed firm name county well located

LANDOWNER: Willie Johnson  
Bourbon, Miss.  
 (mailing address)


description of formations encountered	from	to
<u>Clay</u>	<u>0</u>	<u>38</u>
<u>Sand</u>	<u>38</u>	<u>75</u>
<u>Gravel</u>	<u>75</u>	<u>120</u>
<u>Mud</u>	<u>120</u>	<u>382</u>
<u>Sand</u>	<u>382</u>	<u>430</u>

WELL LOCATION:  
 sec. 13 T 17 N R. 6 W  
1/2 miles E of Bourbon  
 (distance) (direction) (nearest town)

WELL PURPOSE: Home  
 (home, irrigation, municipal, industrial)

- WELL COMPLETION DATA:
- (1) diameter (inches) 4 X 2
  - (2) total depth (feet) 430 ft
  - (3) static water level (feet) 21 below top of ground.
  - (4) casing steel 420  
 (material) (depth)  
4 X 2 if telescope see back.  
 (size)
  - (5) screen 10 420  
 (length) (depth to top)  
2" Stainless Steel  
 (size) (material)
  - (6) pump 1 20  
 (HP) (yield gpm)  
Electric  
 (type power)
  - (7) electric log No  
 (yes or no)  
 (organization running log)
  - (8) how well bottom plugged Back pressure valve

DRILLERS REMARKS:

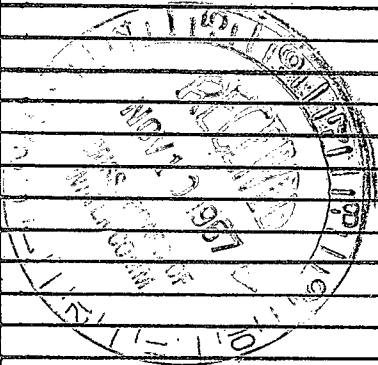

If well telescopes please sketch and show depths.

GROUND LEVEL

10.5' 6"

10' 0"

10' 0" Screen

			10.5

SECTION 1

Please indicate well location X.

ADDITIONAL INFORMATION

If more than one screen, show locations of each on sketch.