


Washington
 J 27
 2-68

MISSISSIPPI
 BOARD OF WATER COMMISSIONERS
 416 North State Street
 Jackson, Mississippi 39201
 WATER WELL DRILLERS LOG

2-3 19 68 Dyer Well & Irr. Ser. Washington
 date well completed firm name county well located


LANDOWNER: Barton Ingram Leland, Miss. (mailing address)	description of formations encountered	from	to
WELL LOCATION: sec. 20 T. 17 N. R. 6 E. W. 3 miles EAST of Bourbon (distance) (direction) (nearest town)	Clay	0	12
	Sand	12	90
	Gravel	125	155
	Clay	155	235
	Sandy Shale	235	265
	Sand	265	305
	Clay & shale	305	375
	Sand	375	455
WELL PURPOSE: Home (home, irrigation, municipal, industrial)	Clay	455	
WELL COMPLETION DATA:			
(1) diameter (inches) 4" X 2"			
(2) total depth (feet) 440 Ft.			
(3) static water level (feet) 21 below top of ground.			
(4) casing 4" Blk. 420 Ft. (material) (depth)			
_____ if telescope see back. (size)			
(5) screen 20 Ft. f420 Ft. (length) (depth to top)			
2" Stainless steel (size) (material)			
(6) pump 1 (HP) 22 (yield gpm)			
Elec. (type power)			
(7) electric log No (yes or no)			
_____ (organization running log)			
(8) how well bottom plugged Wash Valve			
DRILLERS REMARKS:			

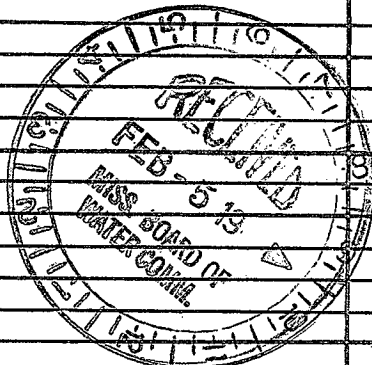

If well telescopes please sketch and show depths.

GROUND LEVEL

Well is 4" X 2" with 126 Ft. of 4"Blk. Pipe at top and connected to 2" Galv. pipe on bottom by means of a 4" X 2" swedge nipple. Straight string of pipe no lap pipe.

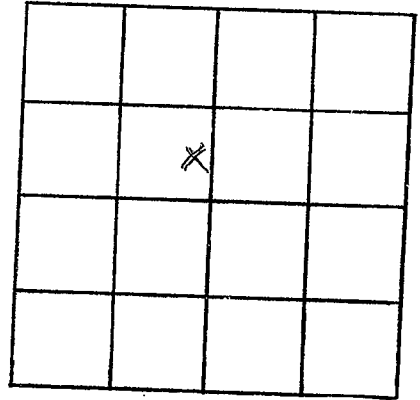

SECTION 20

Please indicate well location X.

ADDITIONAL INFORMATION

If more than one screen, show locations of each on sketch.