

WASH.
 CL-0944 J31
 7-17-78

MISSISSIPPI
 BOARD OF WATER COMMISSIONERS
 416 North State Street
 Jackson, Mississippi 39201

CODED

WATER WELL DRILLERS LOG

7-17 1978 LAYNE CENTRAL CO. WASHINGTON
 date well completed firm name county well located

LANDOWNER:	description of formations encountered	from	to
Julian Potter			
Arcola, MS (mailing address)	clay	0	12
#1 WELL LOCATION: sec. 36 T 17 N R 6 W 2 miles E Trail Lake (distance) (direction) (nearest town)	fine sand	12	32
	coarse sand	32	42
	med. sand	42	52
	coarse sand	52	72
	med. sand	72	80
	coarse sand & gravel	80	115
WELL PURPOSE: Irrigation (home, irrigation, municipal, industrial)	blue clay	115	117
WELL COMPLETION DATA:			
(1) diameter (inches) 12'			
(2) total depth (feet) 117'			
(3) static water level (feet) 20 below top of ground.			
(4) casing Steel 77' (material) (depth)			
12" if telescope see back. (size)			
(5) screen 40' 77' (length) (depth to top)			
12" St. Steel (size) (material)			
(6) pump 25 1200 (HP) (yield gpm)			
diesel (type power)			
(7) electric log no (yes or no)			
(organization running log)			
(8) how well bottom plugged St. Plate			
DRILLERS REMARKS:			

CODED


RECEIVED

NOV 10 1978

MISS. BD. OF WATER COMMISSIONERS

If well telescopes please sketch and show depths.

GROUND LEVEL

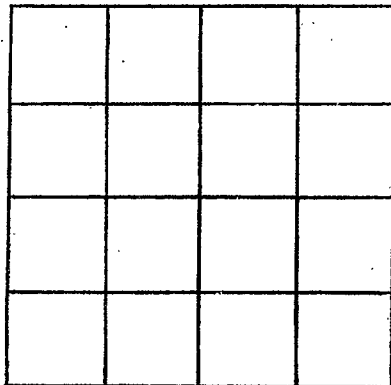

SECTION _____

Please indicate well location X.

ADDITIONAL INFORMATION

If more than one screen, show locations of each on sketch.