

Washington  
J-33  
9/28/79

MISSISSIPPI  
BOARD OF WATER COMMISSIONERS  
416 North State Street  
Jackson, Mississippi 39201

WATER WELL DRILLERS LOG

CODED

9/28 1979 DYER WELL WASHINGTON  
date well completed firm name county well located

LANDOWNER:  
JOHN DILLARD  
ARCOLA  
(mailing address)

description of formations encountered	from	to
Clay	12	28
Fine Sand	28	35
Sand	35	45
Sand & Gravel	45	113

WELL LOCATION:  
sec. 25 T. 17N R. 6 E  
S W  
2 miles E of TRAILAKE  
(distance) (direction) (nearest town)

WELL PURPOSE:  
(home, irrigation, municipal, industrial)

WELL COMPLETION DATA:  
(1) diameter (inches) 16  
(2) total depth (feet) 113  
(3) static water level (feet) 20 below top of ground.  
(4) casing STEEL 73 (material) (depth)  
16 (size) if telescope see back.  
(5) screen 40' 73 (length) (depth to top)  
16 (size) STEEL (material)  
(6) pump 60 3000 (HP) (yield gpm)  
DIESEL (type power)  
(7) electric log NO (yes or no)  
(organization running log)  
(8) how well bottom plugged PLATE

CODED

DRILLERS REMARKS:


DEPT. OF AGRICULTURE  
BOARD OF WATER COMMISSIONERS  
BUREAU OF LAND & WATER RECONSTRUCTION

JAN 16 1980

RECEIVED

If well telescopes please sketch and show depths.

GROUND LEVEL

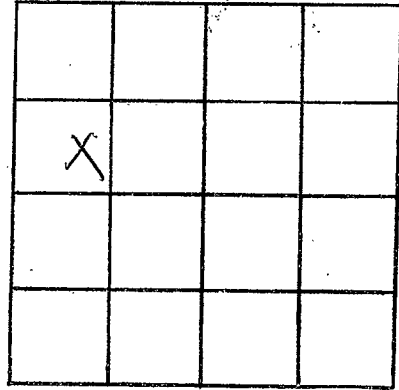

SECTION 25

Please indicate well location X.

ADDITIONAL INFORMATION

If more than one screen, show locations of each on sketch.