

Washington
J-34

MISSISSIPPI
BOARD OF WATER COMMISSIONERS
416 North State Street
Jackson, Mississippi 39201

CODED

10-2-79

WATER WELL DRILLERS LOG

10/2 1979 DYER WELL

WASHINGTON
county well located

LANDOWNER: JOHN DILLARD

description of formations encountered

from to

ARCOLA

(mailing address)

Clay 0 28
Inchbone 28 35
Sand 35 58
Sand & Gravel 58 113

WELL LOCATION:

sec. 25 T-17 N R6 E
2 miles NE of TRAILAKE
(distance) (direction) (nearest town)

WELL PURPOSE: IRRIGATION
(home, irrigation, municipal, industrial)

WELL COMPLETION DATA:

- (1) diameter (inches) 16
- (2) total depth (feet) 113
- (3) static water level (feet) 20 below top of ground.
- (4) casing STEEL 73
(material) (depth)
16" if telescope see back.
(size)
- (5) screen 40' 73
(length) (depth to top)
16 STEEL
(size) (material)
- (6) pump 40 1800-2000
(HP) (yield gpm)
DIESEL
(type power)
- (7) electric log N
(yes or no)

(organization running log)

(8) how well bottom plugged PLATE

DRILLERS REMARKS:

CODED


DEPT. OF NATURAL RESOURCES
BUREAU OF LAND & WATER RESOURCES

JAN 16 1980

RECEIVED

If well telescopes please sketch and show depths.

GROUND LEVEL

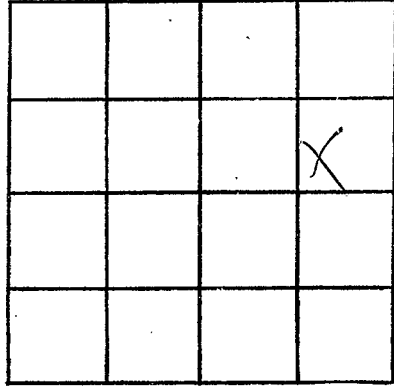

SECTION 25

Please indicate well location X.

ADDITIONAL INFORMATION

If more than one screen,
show locations of each on sketch.