

Washington  
J 37  
3-10-81

MISSISSIPPI DEPARTMENT OF NATURAL RESOURCES  
Bureau of Land and Water Resources  
Southport Mall  
P.O. Box 10631  
Jackson, Mississippi 39209  
WATER WELL DRILLERS LOG

142

3/10 19 81 date well completed  
Dyer firm name  
Washington county well located

LANDOWNER:  
P. K. McHugh  
Inverness, MS.  
(mailing address)

description of formation encountered	CODED	
	from	to
Clay	0	22
Fine Sand	28	38
Sand	38	80
Sand + Gravel	80	113


WELL LOCATION:  
sec. 170 T. 170 S. R. 6 E. (NW)  
2 miles (distance) E (direction) of Tubbett (nearest town)

WELL PURPOSE:  
(home, irrigation, municipal, industrial)  
irrigation

CODED

WELL COMPLETION DATA:

- (1) diameter (inches) 16
- (2) total depth (feet) 113'
- (3) static water level (feet) 21' below above top of ground.
- (4) casing Steel (material) 113' (depth)  
16" (size) if telescopic see back.
- (5) screen 40' (length) 73' (depth to top)  
16" (size) Steel (material)
- (6) pump 60 (HP) 3000 (yield gpm)  
Diaseal (type power)
- (7) electric log (yes or no) \_\_\_\_\_  
(organization running log) \_\_\_\_\_
- (8) how well bottom plugged plate

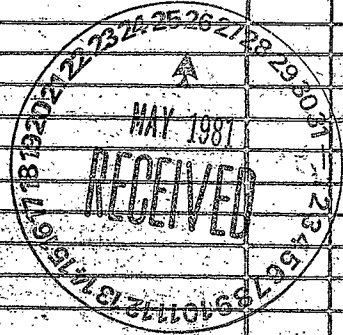

DRILLERS REMARKS:

x			

Sec 1