

Washington

F39

11-4-80

Bureau of Land and Water Resources
Southport Mall
P.O. Box 10631

Jackson, Mississippi 39209

WATER WELL DRILLERS LOG

#2

11/4 1980
date well completed

Dyer
firm name

Wash.
county well located

LANDOWNER:

DILLARD + CO

ARCOLA, MS
(mailing address)

WELL LOCATION:

sec. 23 T. 170 N. R. 6 E. S. 1 W.
2 miles N of Tralake
(distance) (direction) (nearest town)

WELL PURPOSE:

(home irrigation, municipal, industrial)

WELL COMPLETION DATA:

- (1) diameter (inches) 16"
- (2) total depth (feet) 113'
- (3) static water level (feet) 22' below top of ground.
- (4) casing Steel, 113' (material) (depth)
16" (size) If telescope see back.
- (5) screen 40' 73' (length) (depth to top)
16' Steel (size) (material)
- (6) pump 60 3000 (HP) (yield gpm)
Diesel (type power)
- (7) electric log (yes or no)
(organization running log)
- (8) how well bottom plugged plate

description of formations encountered

CODED


from to

Clay	0	20
fine sand	20	24
sand	24	44
sand & gravel	44	113

CODED



DRILLERS REMARKS:

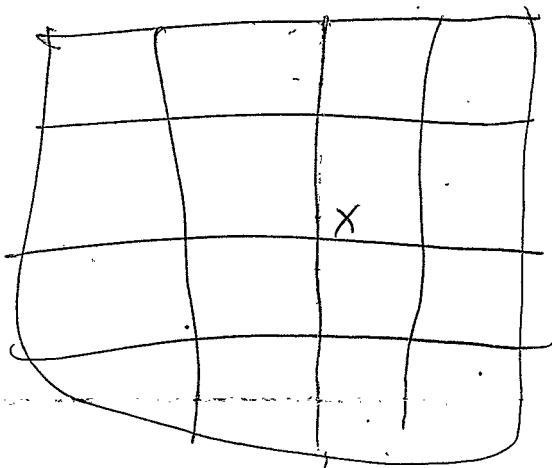

See 23
