

Washington

J40

11-6-80

Bureau of Land and Water Resources

Southport Mall

P.O. Box 10631

Jackson, Mississippi 39209

WATER WELL DRILLERS LOG

3

11/6 80
date well completed

Dyer
firm name

Wash.
county well located

LANDOWNER:

DILLARD + CO

description of formations encountered

CODED

from

to

(mailing address)

WELL LOCATION:

sec 23 T 170 N R 6 E
3 miles S of Lubbock
(distance) (direction) (nearest town)

Clay	0	24
Fine Sand	24	30
Sand	30	38
Sand + Gravel	38	113

WELL PURPOSE:

(home, irrigation, municipal, industrial)


WELL COMPLETION DATA:

- (1) diameter (inches) 16
- (2) total depth (feet) 113'
- (3) static water level (feet) 22' below top of ground
- (4) casing Steel 113' (material) (depth)
- 16" (size) if telescopic see back.
- (5) screen 40' 73' (length) (depth to top)
- 16" (size) Steel (material)
- (6) pump 60 (HP) 3000 (yield gpm)
- Diesel (type power)
- (7) electric log (yes or no)
- (organization running log)
- (8) how well bottom plugged fine

CODED



DRILLERS REMARKS:

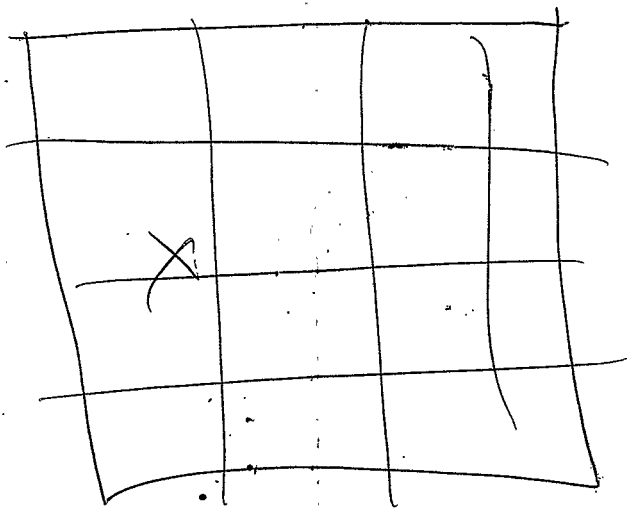

Sec 23