

MISSISSIPPI DEPARTMENT OF NATURAL RESOURCES

Bureau of Land and Water Resources

Southport Mall

P.O. Box 10631

Jackson, Mississippi 39209

WATER WELL DRILLERS LOG

Washington
 43
 7-3-81

7/3 1981 date well completed
 81 Depewille & Sons, Inc. firm name
 Washington county well located

LANDOWNER: John Clew
 Arcola, MS 38722
 (mailing address)

WELL LOCATION:
 sec. 1 T. 17 N. R. 6 E. S. 1
 3 miles S of T. Ribault
 (distance) (direction) (nearest town)

WELL PURPOSE:
 (home, irrigation, municipal, industrial)


WELL COMPLETION DATA:

- (1) diameter (inches) 16
- (2) total depth (feet)
- (3) static water level (feet) 21 below above top of ground.
- (4) casing Steel (material) (depth) 16 (size) if telescope see back.
- (5) screen 40' (length) (depth to top) 16 (size) (material)
- (6) pump 14 3000 (HP) (yield gpm)
 Diesel (type power)
- (7) electric log No (yes or no)

(organization running log)

(8) how well bottom plugged Plato


description of formation encountered	CODED	from	to
Sand		13	23
Sand		23	33
Sand		33	43
gravel		43	53
sand & gravel		53	63
gravel		63	73
gravel		73	83
very fine gravel		83	93
gravel		93	103
gravel		103	113

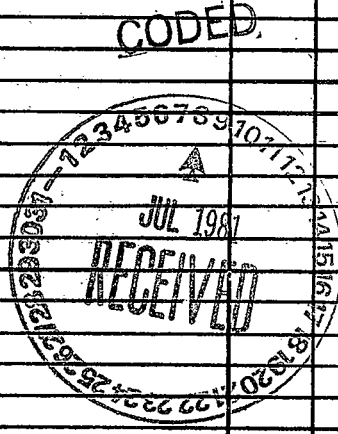

DRILLERS REMARKS:

If well telescopes please sketch and show depths.

GROUND LEVEL

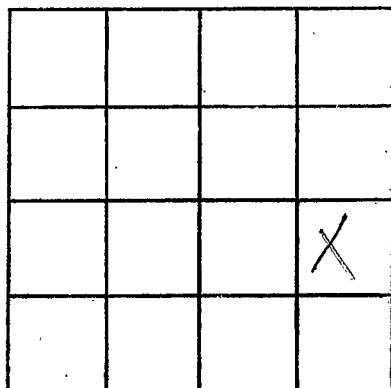

SECTION _____

Please indicate well location X.

ADDITIONAL INFORMATION

If more than one screen,
show locations of each on sketch.