

MISSISSIPPI DEPARTMENT OF NATURAL RESOURCES

Bureau of Land and Water Resources

Southport Mall

P.O. Box 10631

Jackson, Mississippi 39209

WATER WELL DRILLERS LOG

COBED

J 47
 WASHINGTON CO.
 3-25-84

March 25, 1984 Irrigation Equipment, Inc. Washington
 date well completed firm name county well located
 P.O. Box 708 Indianola, Ms. 38751

LANDOWNER: Posey Brown	description of formations encountered	from	to
109 E. Augusta St. Indianola, Ms. 38751 (mailing address)			
	Fine Sand	15	55
	Coarse Sand & Lignite	55	60
	Coarse Sand & Gravel	60	100

WELL LOCATION:
 sec. 12 T 17 S R 6 E
 1/2 miles SW of Bourbon
 (distance) (direction) (nearest town)

WELL PURPOSE: Irrigation
 (home, irrigation, municipal, industrial)

- WELL COMPLETION DATA:
- (1) diameter (inches) 12"
 - (2) total depth (feet) 100'
 - (3) static water level (feet) 18' below top of ground.
 - (4) casing Steel, 60' (material), (depth)
 (size) if telescope see back.
 - (5) screen 40' (length), 60' (depth to top)
 12" (size), Steel (material)
 - (6) pump 60 (HP), 1300 (yield gpm)
 Deisel (type power)
 - (7) electric log (yes or no)

(organization running log)
 (8) how well bottom plugged Steel Plate

DRILLERS REMARKS:

COBED


DEPT. OF NATURAL RESOURCES
 BUREAU OF LAND & WATER RESOURCES

APR 6 1984

RECEIVED

If well telescopes please sketch and show depths.

GROUND LEVEL

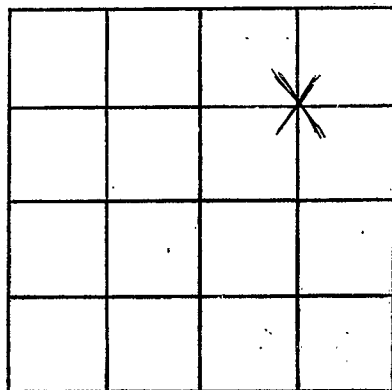

SECTION _____

Please indicate well location X.

ADDITIONAL INFORMATION

If more than one screen,
show locations of each on sketch.