

MISSISSIPPI DEPARTMENT OF NATURAL RESOURCES
Bureau of Land and Water Resources
 Southport Mall
 P.O. Box 10631
 Jackson, Mississippi 39209
WATER WELL DRILLERS LOG

WASHINGTON
J 48

CODED

5-10-84 19 Irrigation Equipment Washington
 date well completed firm name county well located

LANDOWNER: Mike Payne
Leland, Ms 38756
114 Plantation Dr.
Leland, Ms. 38756
 (mailing address)

description of formations encountered	from	to
	Clay	0
Sand	36	75
Sand/gravel	76	115

WELL LOCATION:
 sec. 7 T. 17 N. R. 6 E
8 miles S of Leland
 (distance) (direction) (nearest town)

WELL PURPOSE: Irrigation
 (home, irrigation, municipal, industrial)

WELL COMPLETION DATA:

- (1) diameter (inches) 16"
- (2) total depth (feet) 115'
- (3) static water level (feet) 19 below above top of ground.
- (4) casing steel 75'
 (material) (depth)
- if telescope see back.
 (size)
- (5) screen 40' 75'
 (length) (depth to top)
- 16" steel
 (size) (material)
- (6) pump
 (HP) (yield gpm)
- Diesel
 (type power)
- (7) electric log
 (yes or no)
- (organization running log)
- (8) how well bottom plugged steel plate

DRILLERS REMARKS:

CODED


DEPT. OF NATURAL RESOURCES
 BUREAU OF LAND & WATER RESOURCES

SEP - 4 1984

RECEIVED

If well telescopes please sketch and show depths.

GROUND LEVEL

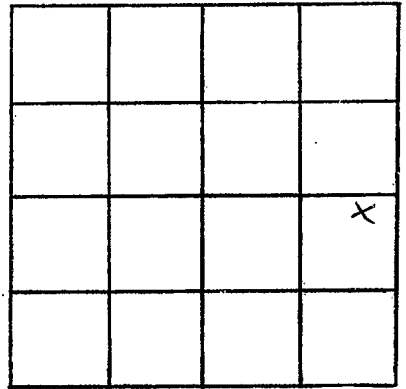

SECTION 7

Please indicate well location X.

ADDITIONAL INFORMATION

If more than one screen,
show locations of each on sketch.