

MISSISSIPPI DEPARTMENT OF NATURAL RESOURCES

Bureau of Land and Water Resources

Southport Mall

P.O. Box 10631

CODED

Jackson, Mississippi 39209

WATER WELL DRILLERS LOG

J51
Washington
7-3-84

July 03 1984 date well completed
Larry's Wells Pump firm name
Washington county well located

LANDOWNER: Dillard Farms

description of formations encountered

from to

Leland, Ms.
(mailing address)

clay	0	30
Fine Sand	30	60
Coarse Sand & gravel	60	112

WELL LOCATION:

sec. 24 T 17 N R 6 E
S W
2 miles N of Trask
(distance) (direction) (nearest town)

WELL PURPOSE: Fish Pond
(home, irrigation, municipal, industrial)

WELL COMPLETION DATA:

- (1) diameter (inches) 16"
- (2) total depth (feet) 112'
- (3) static water level (feet) 23 ^{below}/_{above} top of ground.
- (4) casing Steel, 72'
(material) (depth)
 if telescope see back.
(size)
- (5) screen 40', 72'
(length) (depth to top)
16", steel
(size) (material)
- (6) pump 60 3000
(HP) (yield gpm)
D
(type power)
- (7) electric log No
(yes or no)

(organization running log)

(8) how well bottom plugged Steel Plate

DRILLERS REMARKS:


DEPT. OF NATURAL RESOURCES
BUREAU OF LAND & WATER RESOURCES

NOV 29 1984

RECEIVED

If well telescopes please sketch and show depths.

GROUND LEVEL

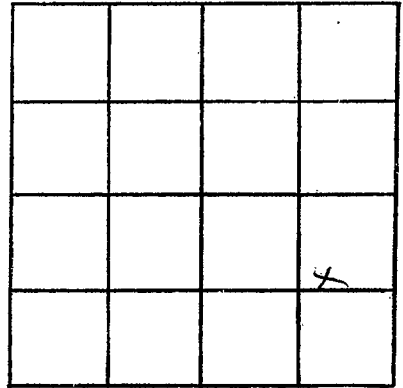

SECTION 24

Please indicate well location X.

ADDITIONAL INFORMATION

If more than one screen,
show locations of each on sketch.