

MISSISSIPPI DEPARTMENT OF NATURAL RESOURCES
 Bureau of Land and Water Resources
 Southport Mall
 P.O. Box 10631
 Jackson, Mississippi 39209
WATER WELL DRILLERS LOG

CODED

Washington
 J52
 7-9-85

7-9-85 date well completed 19 Irrigation Equipment Inc. firm name Washington county well located

LANDOWNER: MIKE PAYNE
114 PLANTATION DRIVE
LELAND, MS 38756
 (mailing address)

description of formations encountered	from	to
fine sand	0	35
COURSE SAND / pea gravel	35	105

WELL LOCATION:
 sec. 8 T. 17 N. R. 6 E.
6 miles south of LELAND
 (distance) (direction) (nearest town)

CODED

WELL PURPOSE: PIVOT
 (home, irrigation, municipal, industrial)

WELL COMPLETION DATA:

- (1) diameter (inches) 16"
- (2) total depth (feet) 105
- (3) static water level (feet) 20 below above top of ground.
- (4) casing steel 65
 (material) (depth)
 (size) if telescope see back.
- (5) screen 40' 65
 (length) (depth to top)
16" steel
 (size) (material)
- (6) pump 110 1800
 (HP) (yield gpm)
Diesel
 (type power)
- (7) electric log NO
 (yes or no)
 (organization running log)
- (8) how well bottom plugged steel plate


RECEIVED
 JUL 22 1985

Department of Natural Resources
 Bureau of Land & Water Resources

DRILLERS REMARKS:

If well telescopes please sketch and show depths.

GROUND LEVEL

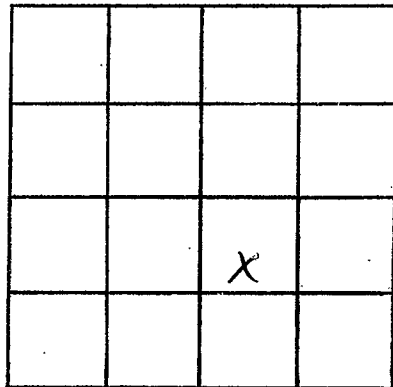

SECTION 8

Please indicate well location X.

ADDITIONAL INFORMATION

If more than one screen,
show locations of each on sketch.