

MISSISSIPPI DEPARTMENT OF NATURAL RESOURCES

Bureau of Land and Water Resources

Southport Mall

P.O. Box 10631

Jackson, Mississippi 39209

WATER WELL DRILLERS LOG

CODED

WASHINGTON
J 53

June 10 1985 date well completed
Fanny's well's pump mm name
Washington county well located

| | | | |
|----------------------------------|---------------------------------------|------|-----|
| LANDOWNER: Lewis Munn | description of formations encountered | from | to |
| | | 0 | 24 |
| Leland, Mo. (mailing address) | CLAY | 24 | 45 |
| | FINE SAND COARSE SAND & GRAVEL | 45 | 106 |


WELL LOCATION:
sec. 7 T. 17 N. R. 6 E. S. 6 W.
4 miles S of Leland
(distance) (direction) (nearest town)

CODED

WELL PURPOSE:
(home, irrigation, municipal, industrial)

WELL COMPLETION DATA:

- (1) diameter (inches) 12"
- (2) total depth (feet) 106'
- (3) static water level (feet) 24' (below top of ground)
- (4) casing Steel, 66' (material) (depth)
(size) if telescope see back.
- (5) screen 40' 66' (length) (depth to top)
12" Steel (size) (material)
- (6) pump 60 (HP) 12000 (yield gpm)
n (type power)
- (7) electric log No (yes of no)
(organization running log)
- (8) how well bottom plugged Steel Plate

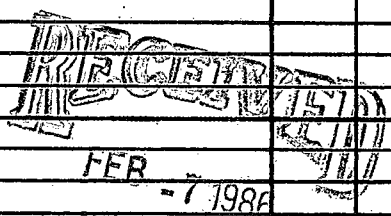


Department of Natural Resources
Bureau of Land and Water Resources

DRILLERS REMARKS:

If well telescopes please sketch and show depths.

GROUND LEVEL

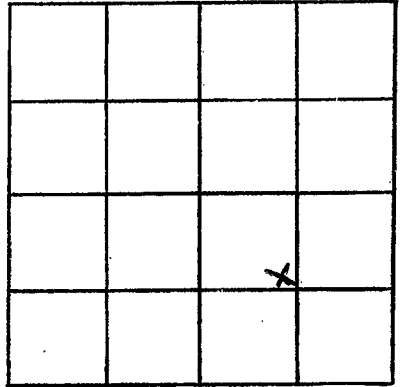

SECTION 7

Please indicate well location X.

ADDITIONAL INFORMATION

If more than one screen,
show locations of each on sketch.