

WASHINGTON
 J 55
 11-10-87

MISSISSIPPI DEPARTMENT OF NATURAL RESOURCES
 Bureau of Land and Water Resources
 Southport Mall
 P.O. Box 10631
 Jackson, Mississippi 39209
 Coded
 WATER WELL DRILLERS LOG

11-10-87 date well completed
 Schultz Drilling firm name
 Washington county well located

LANDOWNER: ROSS PLANTATION
 Box 349
 ARCOLA MS
 (mailing address)

description of formations encountered	from	to
CLAY	0	20
Medium SAND	20	50
COARSE SAND	50	80
SAND + GRAVEL	80	100
GRAVEL	100	105

WELL LOCATION:
 sec. 36 T. 17 N. R. 6 E
 1 miles E of Trail Lake
 (distance) (direction) (nearest town)

WELL PURPOSE: IRRIGATION
 (home, irrigation, municipal, industrial)

- WELL COMPLETION DATA:
- (1) diameter (inches) 16"
 - (2) total depth (feet) 105'
 - (3) static water level (feet) 29' below top of ground.
 - (4) casing PVC, 65' (material), (depth)
 - (5) screen 40', 65' (length), (depth to top)
 16" steel (size), (material)
 - (6) pump 50 (HP), 2500 (yield gpm)
 power unit (type power)
 - (7) electric log NO (yes or no)
 (organization running log)
 - (8) how well bottom plugged CAP

RECEIVED


11-13-1987

Department of Natural Resources
 Bureau of Land and Water Resources

DRILLERS REMARKS:

If well telescopes please sketch and show depths.

GROUND LEVEL

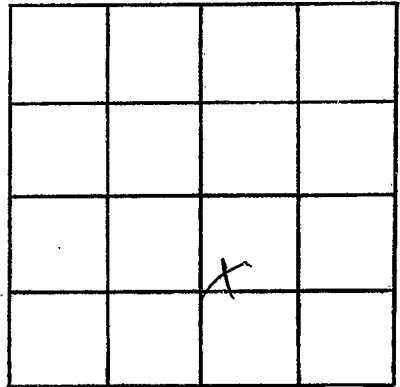

SECTION 36

Please indicate well location X.

ADDITIONAL INFORMATION

If more than one screen,
show locations of each on sketch.