

MISSISSIPPI DEPARTMENT OF NATURAL RESOURCES

Bureau of Land and Water Resources

Southport Mall

P.O. Box 10631

Jackson, Mississippi 39209

WATER WELL DRILLERS LOG

WASHINGTON
 J 56
 11-15-88

Coded

11-15 1988 Schultz Drilling Washington
 date well completed firm name county well located

LANDOWNER: ROSS PLANTATION
 BOX 349
 ARCOLA, MS.
 (mailing address)

description of formations encountered	from	to
CLAY	0	20
SAND	20	50
COARSE SAND	50	80
SAND + GRAVEL	80	100
GRAVEL	100	105

WELL LOCATION:
 sec. 36-17 N R 6 E
 S W
 1 miles E of TRAILAKE
 (distance) (direction) (nearest town)

WELL PURPOSE: IRRIGATION
 (home, irrigation, municipal, industrial)

- WELL COMPLETION DATA:
- (1) diameter (inches) 16"
 - (2) total depth (feet) 105'
 - (3) static water level (feet) 29' below top of ground.
 - (4) casing PVC 65'
 (material) (depth)
 - if telescope see back.
 (size)
 - (5) screen 40' 65'
 (length) (depth to top)
 16" steel
 (size) (material)
 - (6) pump 50 2500
 (HP) (yield gpm)
 pto
 (type power)
 - (7) electric log NO
 (yes or no)
 X
 (organization running log)
 - (8) how well bottom plugged CAP

RECEIVED


JAN 19 1988

Department of Natural Resources
 Bureau of Land and Water Resources

DRILLERS REMARKS:

If well telescopes please sketch and show depths.

GROUND LEVEL

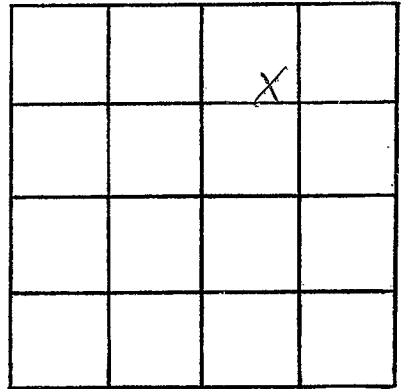

SECTION 36

Please indicate well location X.

ADDITIONAL INFORMATION

If more than one screen,
show locations of each on sketch.