

401-360-0535

State Well Report

Part 1

Mississippi Department of Environmental Quality
Office of Land and Water Resources
P.O. Box 10631
Jackson, MS 39289-0631
(601)961-5210
(601)354-6938 (fax)

County: WASHINGTON
 Permit #: GW-41203
 Driller: JAMES McDONALD
 Date drilling completed: 9-12-05

For Office Use Only:
 Aquifer: _____
 Well #: J-83
 L.S. Elevation: _____
 B-log #: _____

State Law requires that this report be prepared by the driller in detail and filed with the Department within 30 days of completion of drilling of the well.

Well Owner Information	Well Location
Owner Name: <u>Simmons Land Co.</u>	Latitude: <u>33° 17' 30" N</u> Longitude: <u>90° 49' 00" W</u>
Mailing Address: <u>54 Leo Williams Rd.</u>	Method of Lat/Long (circle one): <input checked="" type="radio"/> Conventional Survey, <input type="radio"/> 27
<u>HOLLANDALE Ms 38748</u>	USGS quad, Hand-held GPS, Survey-grade GPS
City State Zip Code	<u>SW 1/4 NW 3/4 Sec 34 Twn 17N Rng 6W</u>
Telephone No: <u>(602) 432-6981</u>	SE SW 27 Distance Direction Nearest Town <u>4.2 Miles EAST of HOLLANDALE</u>

Well Data

Purpose of Well (circle one) Home Industrial Public Supply Irrigation Fish Culture Other: _____

Date well drilling started: 9-12-05 Date well drilling completed: 9-12-05

If flowing, method of flow regulation: Valve _____ Other (describe) _____

Static Water Level: 26 feet above or below (circle one) land surface Date measured: 9-12-05

Method of Measurement (circle one) steel tape electric tape air line other: _____

Hole depth: 123 Well depth: 120 Well grouted to a depth of 10 feet

Type of grout (circle one): Cement Bentonite Mix

Casing length: 90 feet Casing diameter: 6 1/2 inches Type of casing: PVC

Screen length: 30 feet Screen diameter: 1 1/2 inches Type of screen: PVC

Screen slot size: .50 inches Setting depth: From 7.0 feet to 9.5 feet

Type of completion (circle all applicable): Gravel packed Underreamed Telescoped Open hole Natural Development

Other (describe): _____

Top of lap pipe or reduction in casing: _____ feet. If telescoped or more than one screen, describe on back of page

Logs run (circle all applicable): No log run Electric Gamma Ray Density Sonic Neutron Other: _____

Name of organization running log(s): _____

I certify that the well was drilled, constructed, and completed in accordance with all applicable requirements of the Mississippi Department of Environmental Quality and/or the Mississippi Department of Health regulations and state laws.

JAMES McDONALD
Print Name of Water Well Contractor and License No.


James McDonald
Signature of Water Well Contractor

41203

J-83

If well telescopes please sketch below and show depths.

Ground Level

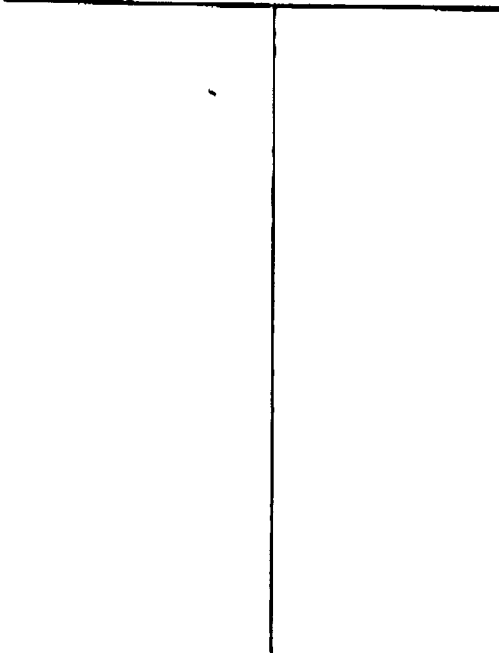

Description of Formations Encountered	From	To
TOP SOIL	0	10
CLAY	10	40
FINE GRAL SAND	40	70
COARSE GRAL SAND	70	95
FINE GRAL SAND	95	115
COARSE SAND	115	120
BLUE CLAY BOTTOM	120	125

If more than one screen, show location of each on sketch

Sketch the property layout and include the following: 1) the well location; 2) any permanent structures on the property that may aid in locating the well; 3) any roads, power lines, or other items that may aid in locating the property and the well; 4) indicate direction.

Landowner Name: Simmons Land Co.

James McDonald
Signature of Water Well Contractor

STATE WELL REPORT

Part 2

Pump Installer's Completion Report
 Mississippi Department of Environmental Quality
 Office of Land and Water Resources
 P.O. Box 10631
 Jackson, MS 39289-0631
 (601)961-5210
 (601)354-6938 (fax)

County: _____
 Permit #: _____
 Driller: JAMES Mc DANIEL
 Date completed: 9-12-05

For Office Use Only:

Aquifer: _____
 Well #: J-53
 Elevation: _____

This report should be prepared by the pump installer in detail and filed with the Department within 30 days of the installation of pump.

Well Owner Information	Well Location
Owner Name: <u>Simmons Land Co.</u>	Latitude: <u>33-17-30N</u> Longitude: <u>90-48-45W</u>
Mailing Address: <u>54 Leo Williams Rd.</u>	Method of Lat/Long (circle one): Conventional Survey <u>87</u>
<u>HOLLANDALE, MS 38748</u>	USGS quad <u>Hand-held GPS</u> Survey-grade GPS
City State Zip Code	<u>SW 1/4 NW 1/4</u> Sec <u>34</u> Twn <u>17N</u> Rng <u>6W</u>
Telephone No. <u>662-432-6980</u>	SE SW Direction <u>27</u> Nearest Town
	<u>4.2</u> Miles <u>EAST</u> of <u>ARCOLA</u>

Pump Type Circle one	Power Type Circle one
Air Lift Jet Submersible	<u>Diesel Engine</u> Gasoline Engine Natural Gas
Bucket Piston <u>Turbine</u>	Electric Motor Hand Tractor PTO
Centrifugal Rotary Flowing Well	Windmill Other (specify): _____
Other (specify): _____	Horse Power Rating of Motor: <u>60</u>
Date Pump Installed: <u>9-13-05</u>	Setting Depth: <u>60</u> feet
Rated Pump Capacity: <u>3000</u> Gallons Per Minute	Number of Stages: <u>1-STAGE 14W</u>

Pump Test Data	Method of Measuring Water Level Circle one
Date Well Tested: _____	Air Line Electric Measuring Line Steel Tape
Static Water Level (A): <u>No Test Performed</u> Feet Below Land Surface	Other (specify): _____
Pumping Water Level (B): _____ Feet Below Land Surface	For flowing well, measured shut in head: _____ feet
Drawdown [(B) - (A)]: _____ Feet Below Land Surface	Well yielded _____ GPM with a drawdown of _____ feet after _____ hours of pumping
Test Pumping Rate: _____ Gallons Per Minute	
Duration of Pump Test (minimum 4 hours): _____ hours	

I HEREBY CERTIFY that the above statements are true to the best of my knowledge.

GLEN Rowe #710P [Signature]
 Print Name of Pump Installer and License No. (if applicable) Signature of Pump Installer