
| County: Washington | State Well Report Part 1 – Driller's Log Mississippi Department of Environmental Quality | For Office Use Only: | |
|--|---|---|--|
| Permit #: GW - 45055 | Office of Land and Water Resources | Aquifer: | |
| Driller: Charles M. Aichols | 4 | Well #: | |
| | Jackson, MIS 39289-0031 | L. S. Elevation: | |
| Date drilling completed: <u>5-30-11</u> | (601)961-5210 (601)354-6938 (fax) | E-log #: | |
| | rt be prepared by the license holder responsible for within 30 days of completion of drilling of the wel | | |
| Information on Well (| | Well or Borehole Location | |
| (Landowner if borehole is not fo | Latitude < 3 ° / 6 392 | N Longitude: GD . SS | |
| Owner Name Susan Suth | erland 33 | Latitude: <u>33°/6</u> , <u>393</u> V Longitude: <u>90°50.</u> 33 Method of Lat/Long (circle one): Conventional Survey, ³³ | |
| Mailing Address: Hunter 1 | Noorh and Method of Lat/Long (circle o | one): Conventional Survey, | |
| 1862 Hus | 4438 USGS quad, Cand-held | USGS quad, <u>Hand-held GPS</u> , Survey-grade GPS SE 4 SW 4 Sec 3.2 Twn 17N Rng GW | |
| Leland MB, <u>38756</u> City State Zip Code Distance Direction | | $\frac{1}{1} \operatorname{Wn} \frac{1}{100} \operatorname{Kng} \frac{640}{100}$ | |
| City Stat | City State Zip Code Distance Direction | | |
| Telephone No. () | | M | |
| | Well / Borehole Data | | |
| Logg run (gircle all applicable): No log ru | er used for drilling: <u>the Bogue</u> e used in drilling and development: <u>HTH</u> | Other | |
| Name of organization running log(s): | Electric Gamma Ray Density Sonic Neutron | | |
| Name of organization running log(s): | Electric Gamma Ray Density Sonic Neutron | | |
| Name of organization running log(s): Purpose of borehole (check one): Water W Seismic S | Electric Gamma Ray Density Sonic Neutron | d Source Heat Pump | |
| Name of organization running log(s): Purpose of borehole (check one): Water W Seismic S If drilling is not related | Electric Gamma Ray Density Sonic Neutron ell Geotechnical/Geological Investigation Ground Survey Other (<i>describe</i>) | d Source Heat Pump | |
| Name of organization running log(s): Purpose of borehole (check one): Water W Seismic S If drilling is not related | Electric Gamma Ray Density Sonic Neutron ell <u>Geotechnical/Geological Investigation</u> Ground Survey Other (<i>describe</i>) to water well construction, skip the remainder of this bind ndustrial Public Supply Irrigation Fish Culture | d Source Heat Pump | |
| Name of organization running log(s): Purpose of borehole (check one): Water W Seismic S <i></i> | Electric Gamma Ray Density Sonic Neutron [ellGeotechnical/Geological Investigation Ground Survey Other (<i>describe</i>) to water well construction, skip the remainder of this bin ndustrial Public Supply Irrigation Fish Culture | d Source Heat Pump lock Other: | |
| Name of organization running log(s): Purpose of borehole (check one): Water W Seismic S <i></i> | Electric Gamma Ray Density Sonic Neutron fell Geotechnical/Geological Investigation Ground Survey Other (<i>describe</i>) <i>to water well construction, skip the remainder of this bi</i> ndustrial Public Supply Irrigation Fish Culture on: Valve Other (describe) sove or below (circle one) land surface Date measured; | d Source Heat Pump lock Other: | |
| Name of organization running log(s): Purpose of borehole (check one): Water W Seismic S If drilling is not related Purpose of Well (check one): Home In If a flowing well, method of flow regulation Static Water Level:feet ab Method of Measurement (circle one) Well depth: /_2D Well grouted to a de | Electric Gamma Ray Density Sonic Neutron fell Geotechnical/Geological Investigation Ground Survey Other (describe) to water well construction, skip the remainder of this bind industrial Public Supply Irrigation Fish Culture on: Valve Other (describe) Nove of below (circle one) land surface Date measured: electric tape air line other: pth of / feet Type of grout (circle one): Near Cent | d Source Heat Pump | |
| Name of organization running log(s): Purpose of borehole (check one): Water W Seismic S If drilling is not related Purpose of Well (check one): Home In If a flowing well, method of flow regulation Static Water Level:feet ab Method of Measurement (circle one) Well depth: /_2D Well grouted to a de | Electric Gamma Ray Density Sonic Neutron fell Geotechnical/Geological Investigation Ground Survey Other (describe) to water well construction, skip the remainder of this bind industrial Public Supply Irrigation Fish Culture on: Valve Other (describe) Nove of below (circle one) land surface Date measured: electric tape air line other: pth of / feet Type of grout (circle one): Near Cent | d Source Heat Pump | |
| Name of organization running log(s): Purpose of borehole (check one): Water W Seismic S If drilling is not related Purpose of Well (check one): Home In If a flowing well, method of flow regulation Static Water Level: feet ab Method of Measurement (circle one) Well depth: Well grouted to a de Casing length: feet Casin Screen length: feet Screen | Electric Gamma Ray Density Sonic Neutron [ellGeotechnical/Geological InvestigationGround SurveyOther (describe) [to water well construction, skip the remainder of this bind IndustrialPublic SupplyIrrigationFish Culture In: ValveOther (describe) wove of below (circle one) land surface Date measured: [eel tapbelectric tape air line other: pth offeet Type of grout (circle one): Near Centre and diameter:finches Type of screen: | d Source Heat Pump | |
| Name of organization running log(s): Purpose of borehole (check one): Water W Seismic S If drilling is not related Purpose of Well (check one): Home In If a flowing well, method of flow regulation Static Water Level: feet ab Method of Measurement (circle one) Well depth: Well grouted to a de Casing length: feet Casin Screen length: feet Screen | Electric Gamma Ray Density Sonic Neutron fell Geotechnical/Geological Investigation Ground Survey Other (describe) to water well construction, skip the remainder of this binned industrial Public Supply Irrigation Fish Culture on: Valve Other (describe) Survey of below (circle one) land surface Date measured: electric tape air line other: | d Source Heat Pump | |
| Name of organization running log(s): Purpose of borehole (check one): Water W Seismic S If drilling is not related Purpose of Well (check one): Home In If a flowing well, method of flow regulation Static Water Level: feet ab Method of Measurement (circle one) Well depth: Well grouted to a de Casing length: feet Casin Screen length: feet Screen | Electric Gamma Ray Density Sonic Neutron fellGeotechnical/Geological InvestigationGround SurveyOther (describe) to water well construction, skip the remainder of this binned industrialPublic SupplyIrrigationFish Culture on: ValveOther (describe) nove of below (circle one) land surface below of below (circle one) land surface teel tapeOther (describe) electric tape Date measured: electric tape air line other (other: pth of feet Type of grout (circle one): Near Cert ng diameter: inches Type of screen: Setting depth: From Feet to | d Source Heat Pump | |
| Name of organization running log(s): Purpose of borehole (check one): Water W Seismic S If drilling is not related Purpose of Well (check one): HomeI If a flowing well, method of flow regulation Static Water Level:S feet ab Method of Measurement (circle one) Well depth: feet ab Well depth: feet Casin Screen length: feet Screen Screen slot size: J35 inches | Electric Gamma Ray Density Sonic Neutron fellGeotechnical/Geological InvestigationGround SurveyOther (describe) to water well construction, skip the remainder of this binned industrialPublic SupplyIrrigationFish Culture on: ValveOther (describe) nove of below (circle one) land surface below of below (circle one) land surface teel tapeOther (describe) electric tape Date measured: electric tape air line other (other: pth of feet Type of grout (circle one): Near Cert ng diameter: inches Type of screen: Setting depth: From Feet to | d Source Heat Pump | |

The sketch below only required for water wells

If well telescopes, show depths on sketch. Ground Level Description of formations encountered must be provided for all wells and boreholes, unless specifically exempted by regulations

| Description of Formations Encountered | | To (depth) |
|---|---------------------------------------|------------|
| Clan | Ground Level | 15 |
| Sand | 15 | 40 |
| Course sand + p-gravel Sand + gravel | 40 | 90 |
| find + argues | 90 | 120 |
| - 0 | | |
| | | |
| | | |
| | | 1 |
| | · · · · · · · · · · · · · · · · · · · | 1 |
| | | 1 |

If more than one screen, show location of each on sketch

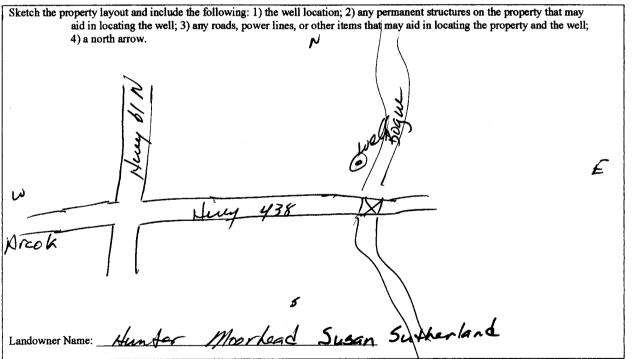

Form: OLWR-SWR-1A

I certify that the well/borehole was drilled, constructed, and completed in accordance with all applicable requirements of the Mississippi Department of Environmental Quality and the Mississippi Department of Health regulations, if applicable, and state

Date

laws. M. Aichols 0-0667 12-23-11 Charles

Print Name of Responsible Licensee and License No.

Charles M. An Tal Signature of Licensee JI27

| STATE WELL REPORT | | | | | | |
|---|--|---|---------------------------------------|--|--|--|
| County: <u>Washington</u> Permit #: <u>w6 - 45055</u> Driller: <u>Charles M. Alchols</u> Date completed: <u>5-30 71</u> | Part 2 Pump Installer's Completion Report Mississispi Department of Environmental Quality Office of Land and Water Resources P.O. Box 10631 Jackson, MS 39289-0631 (601)961-5210 | | For Office Use Only: Aquifer: | | | |
| Copy information from block on Part 1 | (601)354-6938 (fax) | | | | | |
| This part of the report must be completed by a licensed water well contractor or a licensed pump installer. A copy of Part 1 of the | | | | | | |
| Well Owner Information | | Well Location | | | | |
| Owner Name: _Susan Sutherland | | Latitude: 33°/6, 383 N Longitude: 90 50, 5580 | | | | |
| Mailing Address: Hunter Moorhead | | Method of Lat/Long (check one): Conventional Survey | | | | |
| 1862 Huy 438 | | USGS quad, Hand-held GPS 2. Survey-grade GPS | | | | |
| Lefand Mb. 35-256 City State Zip Code | | <u>SE 45W 4 Sec 32 TITN R 6W</u> | | | | |
| | - | Distance Direction | Nearest Town | | | |
| Telephone No. () | | <u>_2_Miles</u> <u>East</u> of | Arcola | | | |
| Pump Type Circle one | | Power Type Circle one | | | | |
| Air Lift Jet | Submersible | Piesel Engine Gasoline | e Engine Natural Gas | | | |
| Bucket Piston | Turbine | Electric Motor Hand | Tractor PTO | | | |
| Centrifugal Rotary | Flowing Well | | specify): | | | |
| Other (specify): | | Horse Power Rating of Motor: 60 | | | | |
| Date Pump Installed: 5-30 - 11 | | Setting Depth:feet | | | | |
| Rated Pump Capacity: 2500 | Gallons Per Minute | Number of Stages: 2×1 | <u> </u> | | | |
| Pump Test Data | | Method of Measuring Water Level Circle one | | | | |
| Date Well Tested: | | Air Line Electric Meas Other (specify): | | | | |
| Pumping Water Level (B):Feet 1 | Below Land Surface | (openny) / | · | | | |
| Drawdown [(B) – (A)]:Feet | Below Land Surface | For flowing well, measured shut in head:feet | | | | |
| Test Pumping Rate: | Gallons Per Minute | Well yieldedGPM with a drawdown of | | | | |
| Duration of Pump Test (minimum 4 hours): | hours | feet after | hours of pumping | | | |
| I HEREBY CERTIFY that the above statem | nents are true to the best of | of my knowledge. | | | | |

۱ پ

Charles M. Alchols 0-0667 Print Name of Pump Installer and License No. (if applicable) Charles M. Thillole Signature of Pump Installer Form: OLWR-SWR-1B