

STATE WELL REPORT

Part 1

Driller's Log

Mississippi Department of Environmental Quality
Office of Land and Water Resources
P.O. Box 2309
Jackson, MS 39225-2309
(601)961-5555
(601)961-5228 (fax)

For Office Use Only:

Well #: **J135**
Aquifer: _____
E-Log #: _____

County: Washington - MS
Permit #: _____
Driller: Roland W Tollett (RMO-00009026)
Date drilling completed: 07-30-2019

USGS site name: BP-04a-EC

State Law requires that this report be prepared by the license holder responsible for the work and filed with the Department at the above address within 30 days of completion of drilling of the well or borehole.

RECEIVED
12-03-2019
BY OLWR

Well Owner Information <i>(Landowner if borehole is not for a water well)</i> Owner Name: <u>Bubba Simmons (landowner)</u> Mailing Address: <u>USGS (driller - rtollett@usgs.gov)</u> <u>3095 W. California Ave</u> Ruston LA 71270 City State Zip Code Telephone No. (<u>318</u>) <u>251-9630 (245-8639 cell)</u>	<input checked="" type="checkbox"/> Well or <input type="checkbox"/> Borehole Location Latitude: <u>33.28159</u> Longitude: <u>-090.83719</u> Method of Lat/Long (check one): Conventional Survey _____, USGS quad _____, Hand-held GPS <u>X</u> , Survey-grade GPS _____ <u>NE 1/4 NE 1/4, Sec 32 T 17N R 06W</u> <u>3</u> Miles <u>E/NE</u> of <u>Arcola, MS</u> <i>(Distance) (Direction) (Nearest Town)</i>
--	---

Well / Borehole Data Date drilling started: <u>7/30/19</u> Date drilling completed: <u>7/30/19</u> Hole depth: <u>98 ft bls</u> Hole diameter: <u>3.25 in</u> Location of the source of any surface water used for drilling: <u>none used</u> Method of dosing and volume of Chlorine used in drilling and development: <u>none used</u> Logs run (check applicable): <input type="checkbox"/> No log run <input checked="" type="checkbox"/> Electric <input type="checkbox"/> Gamma Ray <input type="checkbox"/> Density <input type="checkbox"/> Sonic <input type="checkbox"/> Neutron <input type="checkbox"/> Other: _____ Name of organization running log(s): <u>USGS, 3095 W. California Ave, Ruston, LA 71270 (318) 251-9630 x13</u> Purpose of borehole (check one): <input type="checkbox"/> Water Well <input checked="" type="checkbox"/> Geotechnical/Geological Investigation <input type="checkbox"/> Ground Source Heat Pump <input type="checkbox"/> Seismic Survey <input type="checkbox"/> Other (describe) _____ <i>If drilling is not related to water well construction, skip the remainder of this block</i> Purpose of Well (check all applicable): <input type="checkbox"/> Home <input type="checkbox"/> Industrial <input type="checkbox"/> Public Supply <input type="checkbox"/> Irrigation <input type="checkbox"/> Fish Culture <input checked="" type="checkbox"/> other Other (describe): <u>monitoring well</u> If a flowing well, method of flow regulation: Valve _____ Other (describe) _____ Static Water Level: <u>14.35</u> feet <input type="checkbox"/> above or <input checked="" type="checkbox"/> below land surface Date measured: <u>7/31/2019 @ 1030</u> <i>(check one)</i> Method of measurement (check one) <input type="checkbox"/> Steel tape <input checked="" type="checkbox"/> Electric tape <input type="checkbox"/> Air line <input type="checkbox"/> Other (describe): _____ Well depth: <u>81</u> Well grouted to a depth of: <u>30</u> feet Type of grout (check one): <input checked="" type="checkbox"/> Neat Cement <input type="checkbox"/> Bentonite <input type="checkbox"/> Mix Casing length: <u>71</u> feet Casing diameter: <u>2</u> inches Type of casing: <u>PVC</u> Screen length: <u>10</u> feet Screen diameter: <u>2</u> inches Type of screen: <u>PVC</u> Screen slot size: <u>.010</u> inches Setting depth: From <u>71</u> feet to <u>81</u> feet Type of completion (check all applicable): <input type="checkbox"/> Gravel packed <input type="checkbox"/> Underreamed <input type="checkbox"/> Open hole <input checked="" type="checkbox"/> Natural Development Other (describe): _____ Top of lap pipe or reduction in casing: <u>NA</u> feet <i>If telescoped or more than one screen, describe on next page</i>
--

Driller: Roland W Tollett, USGS, 3095 W California Ave, Ruston, LA 71270 [318-245-8639] (MS LIC RMO-00009026)

Site number: BP-04a-EC

Drill date: 20190730

Plugged date: active monitoring well

Site type: USGS monitoring well

EC-log depth ~98 ft bls

Rig Type: Geoprobe 7822DT with EC-HPT probe

Lat/Long 33.28159 -090.83719 +-8ft

Sec Township Range: NE1/4,NE1/4,S32,T17N,R06W

Land surface elevation: 33.5 meters (110 feet) [data source: DEM]

Topo Map Name: Tribbett, MS

County/Parish: 151 Washington County, MS (1:24,000)

HUC code: 080302071402 Fourmile Bayou Bogue

Associated well in USGS NWIS: 331654090501401

Land owner: Bubba Simmons



***** USER NOTES *****

Drilled by Roland (USGS Ruston LA) and Wesley Bolton (USDA ARS Oxford MS) and Will (USDA ARS Oxford MS).

EC-HPT log notes:

0-5 ft bls was mostly clay with some silty zones. We saw a silty brown clay on the rod wiper which is typically found in the shallower intervals.

5-15 ft bls was mostly clayey silts and clay

15-30 ft bls was mostly clayey silts

30-98 ft bls was mostly fine to medium sand, with thin clay lenses at 85-98 ft bls

Note that 80-90 ft bls was hard to push.

Noticeable change at 80 ft bls (more diff to push rods), as the Geoprobe had a slight shake, tight feel during hammering/pushing. There appears to be a clay lens at 85-90 ft bls.

Cores will also be collected at this site.

HPT log: The last 11 dissipation tests produced a theoretical water level of about 13.8 ft bls which matched the measured WL of 14.35 ft bls very well.

Well construction: This 2" PVC monitoring well is ~85 ft from bottom of point to TOC with a 10 ft screen; screened interval is ~71-81 ft bls; MP is 3.00 above land surface with aluminum protective riser and 2 ft radius concrete slab; a 4" point was added to btm of casing; about 10 gallons of tap water were poured into PVC casing prior to pulling rods; this technique was used to balance and equalize pressure.

About 2 cups of bentonite granules were poured into the annular space of the borehole and bridged over around 20 ft below land surface (bls). Portland cement at a tap water ratio of 5-6 gals per 92-lb bag was used to seal the borehole from about 30 ft bls to land surface.


Water level:

7/31/19 @ 1030 = 18.35 - 1.00 - 3.00 = 14.35 ft bls measured with e-tape by Roland W Tollett of the USGS.


*Note that all water level tapes used by the USGS are calibrated by the HIF.

USGS Borehole BP-04a-EC (continued)

Figure 1. Graph of all dissipation tests and EC-log showing 12 dissipation points from both the unsaturated and saturated zones.

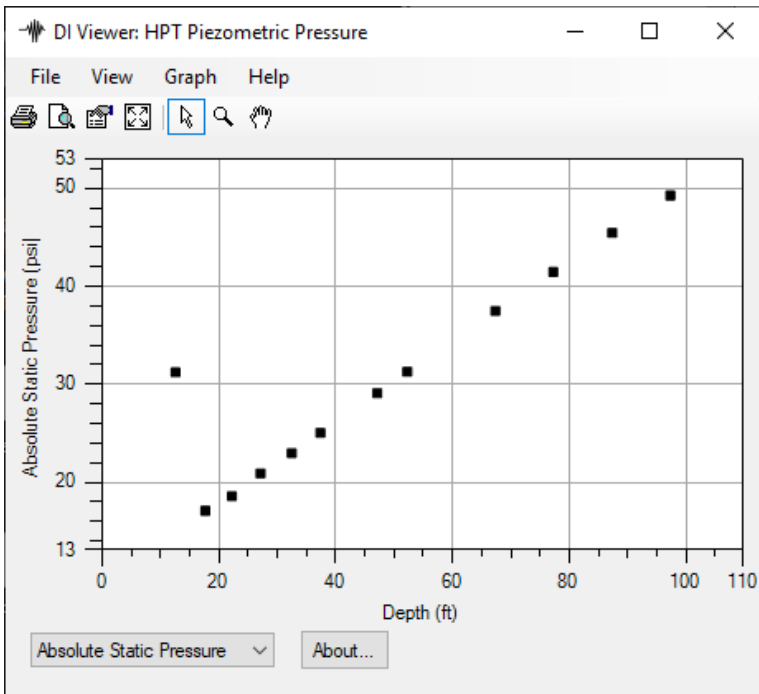


RECEIVED
12-03-2019
BY OLWR

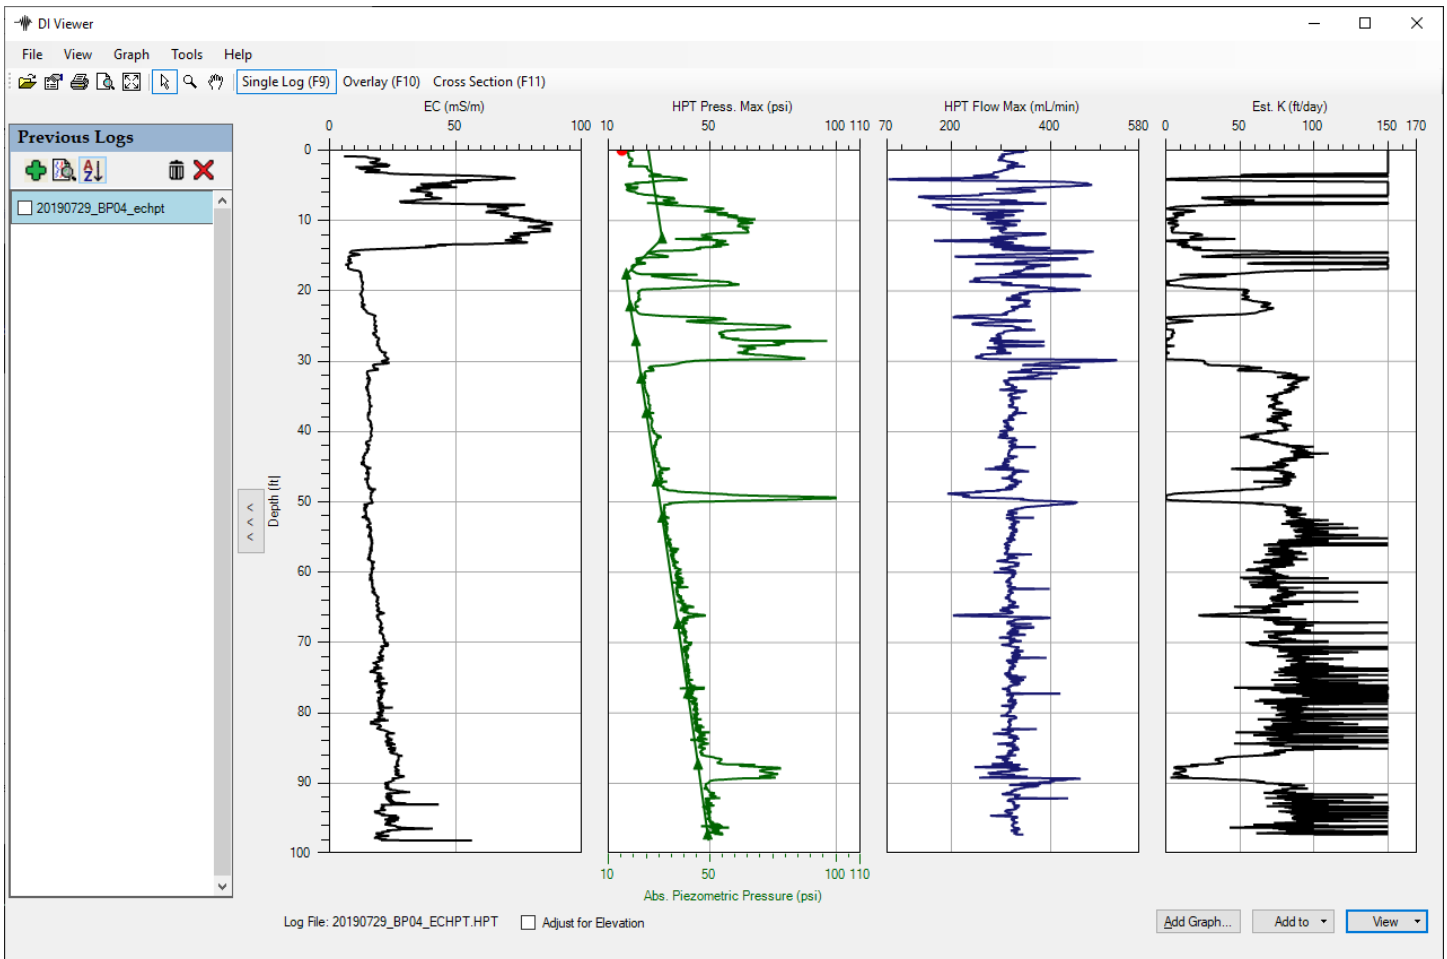


USGS Borehole BP-04a-EC (continued)

Figure 2. Graph of dissipation tests and EC-log showing the best 11 dissipation points and the associated calculated estimated hydraulic head. The water level was estimated to be 13.8 ft bls from the dissipation tests, which is a good estimate of the actual water level measured of 14.35 ft bls.

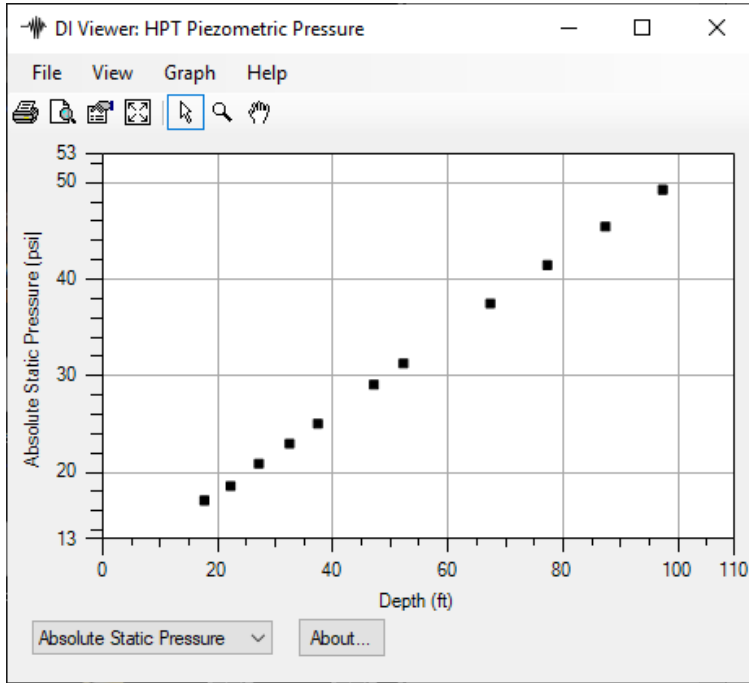

RECEIVED
12-03-2019
BY OLWR

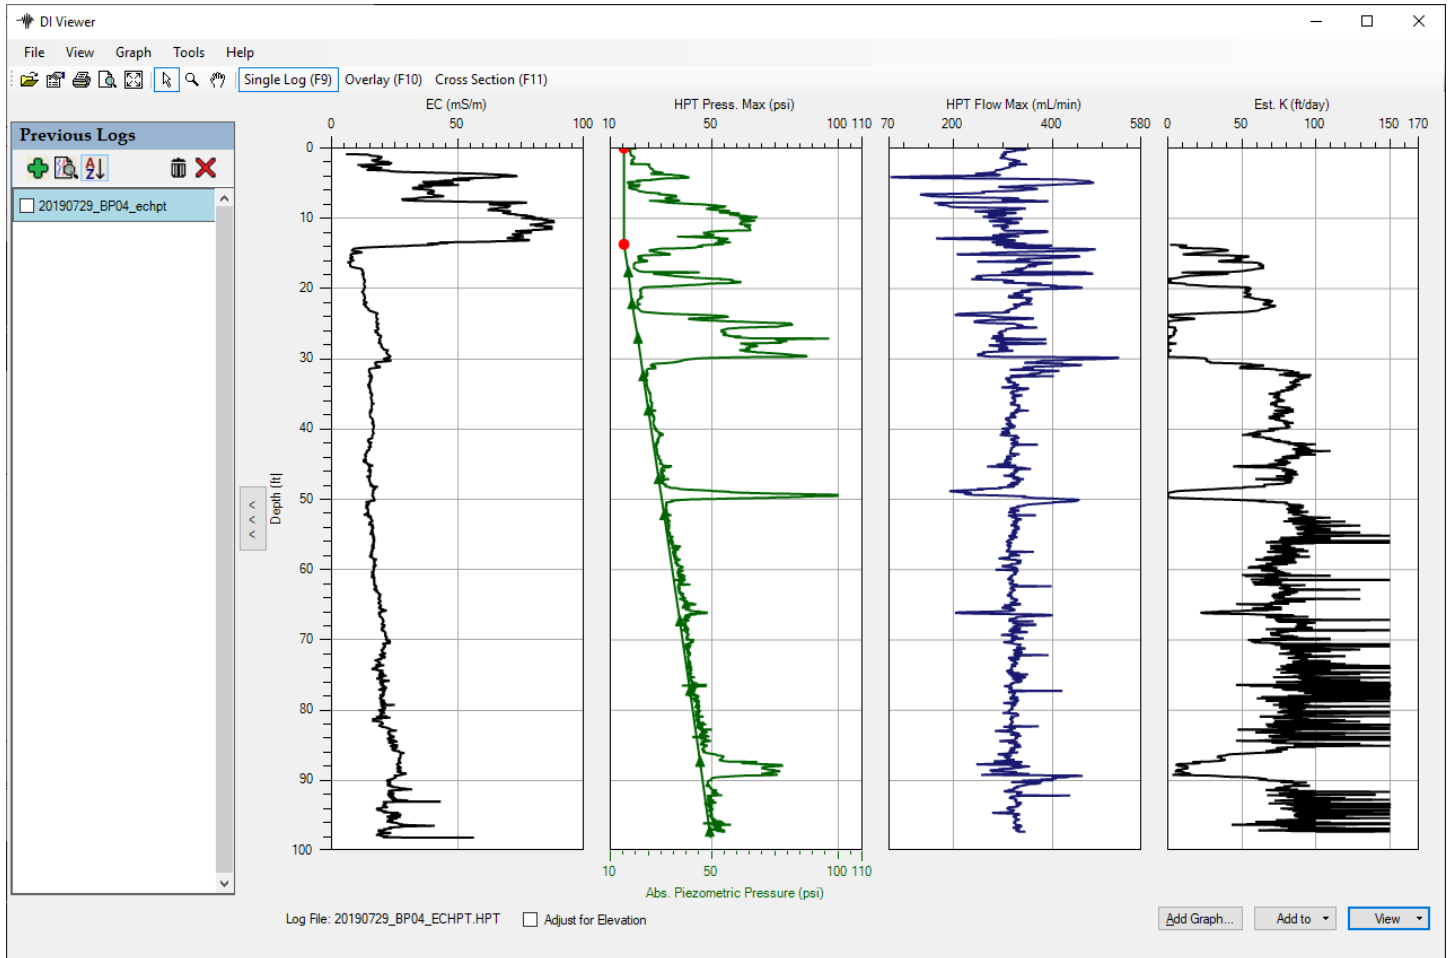

USGS Borehole BP-04a-EC (continued)

20190729_BP04_echpt.zip
SITE INFORMATION -- DIRECT IMAGE HPT PROBE
Geoprobe DI Acquisition Software for Windows
Version: 3.2 Build: 18113



Pre-Log EC Load Tests

Test	Target (mS/m)	Actual (mS/m)	% Diff	P/F
Test 1	195.0	205.8	5.6	PASS
Test 2	97.0	101.7	4.8	PASS
Test 3	24.0	25.2	5.1	PASS

COMPANY: Geoprobe
OPERATOR: rtollett
PROJECT ID: usgs_office
CLIENT: USGS
UNITS: ENGLISH
PROBE AND ARRAY: K6050 HPT Probe with Wenner
LOCATION: LA
100 INCH STRING POT USED
ROD LENGTH: 5 feet

PRE-LOG HPT REFERENCE TEST VALUES

PRE TEST TIME: Mon Jul 29 2019 14:22:10

TEST	HPT PRESSURE (psi)	FLOW (mL/min)	HPT PRESSURE (kPa)
TOP with FLOW=0	16.010	0.0	110.380
TOP with FLOW>0	15.732	0.0	108.470
BOTTOM with FLOW=0	15.788	0.0	108.850
BOTTOM with FLOW>0	15.522	0.0	107.020

EXPECTED FLOW=0 HPT DIFF.: 0.22 psi (1.5 kPa) +/- 10%
ACTUAL FLOW=0 HPT DIFF.: 0.22 psi (1.5 kPa)

TRANSDUCER TEST PASSED

HPT IDEAL COEFFS: 2.2696e1,-2.2356
HPT SENSOR CAL NUMBERS: XD30959A,0.0000,0.0000,0.0000,0.0000,9.9490e-1,-1.3100
LOG START TIME: Mon Jul 29 2019 14:30:13

LOG END DEPTH: 97.30 ft (29.657 m)
LOG END TIME: Mon Jul 29 2019 15:32:07

LATITUDE: 33.281590000
LONGITUDE: -90.837190000
ELEVATION: 0.000 METERS 0.00 FEET
GPS Quality: Manual

USGS Borehole BP-04a-EC (continued)

POST-LOG HPT REFERENCE TEST VALUES

POST TEST TIME: Mon Jul 29 2019 16:04:01

TEST	HPT PRESSURE (psi)	FLOW (mL/min)	HPT PRESSURE (kPa)
TOP with FLOW=0	15.603	0.0	107.580
TOP with FLOW>0	15.886	312.0	109.530
BOTTOM with FLOW=0	15.403	0.0	106.200
BOTTOM with FLOW>0	15.678	316.4	108.090

EXPECTED FLOW=0 HPT DIFF.: 0.22 psi (1.5 kPa) +/- 10%

ACTUAL FLOW=0 HPT DIFF.: 0.20 psi (1.4 kPa)

TRANSDUCER TEST PASSED

Post-Log EC Load Tests

Test	Target (mS/m)	Actual (mS/m)	% Diff	P/F
Test 1	195.0	213.6	9.5	PASS
Test 2	97.0	105.6	8.8	PASS
Test 3	24.0	26.4	10.0	PASS

***** USER NOTES *****


Pushed by rwt and wesley bolton on 7/29.2019.

Clay lens from 5 to 15 ft bls. Silty clayey from 15 ft bls to end of log. The silt was very fine grained and medium to dark gray in color (nasty stuff).

Rods pushed difficult from 82 ft bls to 90 ft bls. Note that the HPT pressure increased in certain lenses but the EC was fairly consistent.

Core intervals likely: 10-15; 25-30; 40-45; 60-65?



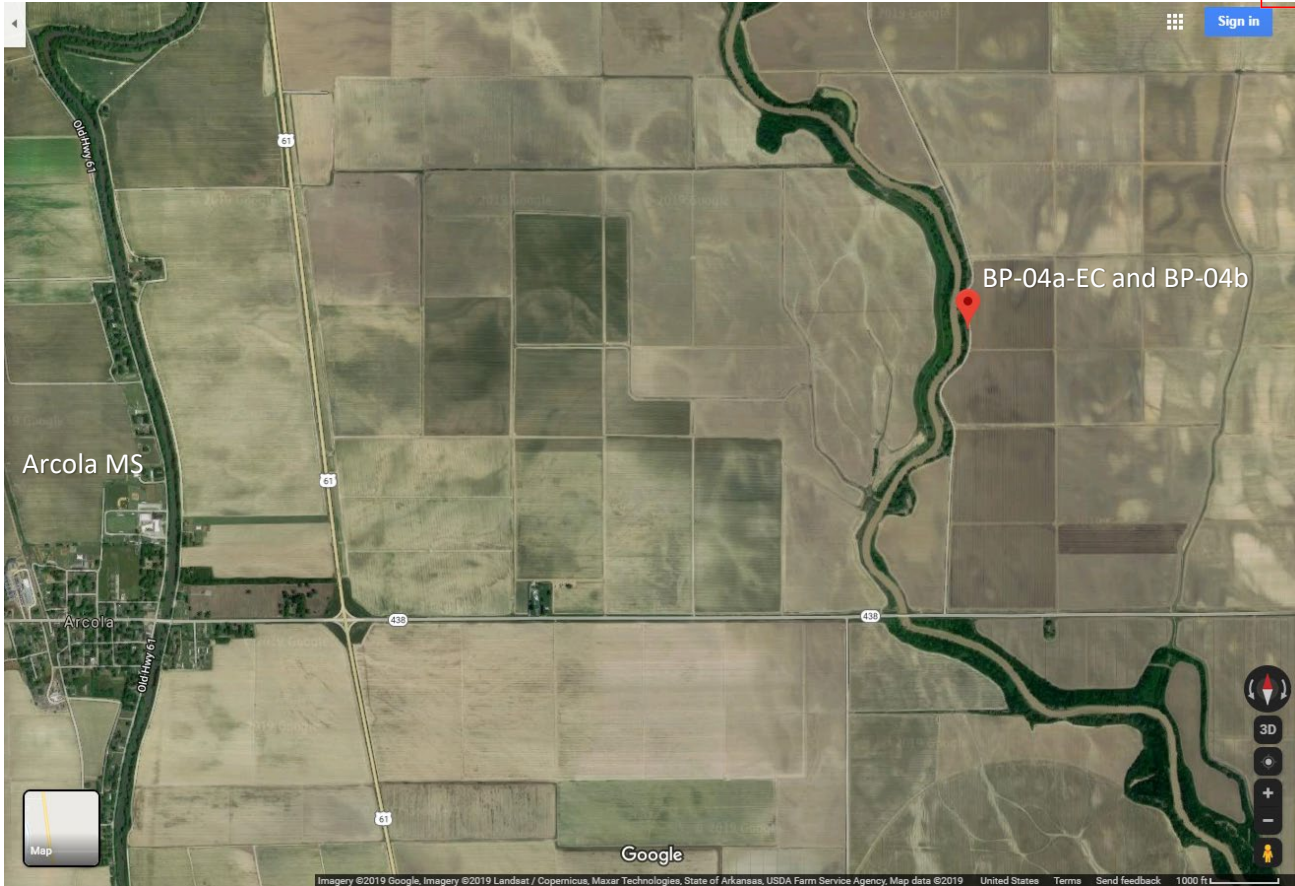

USGS Borehole BP-04a-EC (continued)

New Site Sheet Form - MAPS

File Tables Search Network Help

NEW SITE

Site Record
Agency Code: USGS : U.S. Geological Survey Site Number: 331654090501401 Site Type Code: GW
Station Name: BP-04a-EC Agency Use Code: []

Coordinate/Altitude Data
Latitude: 331653.72 Longitude: 0905013.88 Coordinate Accuracy: H: Hndrth secon Coordinate Method: G: GPS
Coordinate Datum: NAD83: NA Datum of 1983 Latitude NAD83 in decimal degrees Longitude NAD83 in decimal degrees
Altitude in ft: 110 Altitude Datum Code: NAVD88: V Datum of 1988 Altitude Method Code: N: DEM Altitude Accuracy Value in ft: []

Surface Water Data
Drainage Area in sq mi: [] Basin Code: []
Contributing Drainage Area in sq mi: []
Hydrologic Unit Code: 080302071402: Fourmile Bayou-Bogue

Spatial Data
Land Net: S32 T17N R06W 0 Topographic Code: []
Map Name: TRIBBETT, MS Map Scale: 24000

Groundwater Data
Aquifer Code: []
National Aquifer Code: []
Aquifer Type Code: []
Well Depth in ft: []
Hole Depth in ft: []
Source of Depth: []

Administrative Data
Country Code: US: United States
State Fips Code: 28: Mississippi
County Fips Code: 151: Washington
Minor Civil Division: 91422: District 2
District Code: 28: MISSISSIPPI
Time Zone Code: CST : Central Standard
Daylight Savings Time Flag: Y: Yes

Use Data
Primary Use of Site: []
Secondary Use of Site: []
Tertiary Use of Site Code: []
Primary Use of Water Code: []
Secondary Use of Water Code: []
Tertiary Use of Water Code: []
National Water Use Code: []

Data Collection and Dates
Data Reliability Code: [] Site Establishment Date: [][][] First Construction Date: [][][]
Instruments: [] Data Types: []
Remarks: [] Project Number: []

Record Data
Created by: [] Date: [][][] Modified by: [] Date: [][][] Web Ready: C: Data Not Checked



RECEIVED
12-03-2019
BY OLWR

RECEIVED
12-03-2019
BY OLWR

