

WASHINGTON

J 2000

5-20-77

MISSISSIPPI BOARD OF WATER COMMISSIONERS  
416 North State Street  
Jackson, Mississippi 39201

WATER WELL DRILLERS LOG

5/20 1977 date well completed

154  
firm name

Washington county well located

154  
1977 Schultz Drilling, Washington

LANDOWNER:

C. N. Manages Landis

Burbon Miss  
(mailing address)

description of formations encountered

from

to

TOP Soil

0 17

sand

17 80

WELL LOCATION:

sec 14 T. 17 N R. 6 E

0 miles 0 of Burbon  
(distance) (direction) (nearest town)

WELL PURPOSE:

Home  
(home, irrigation, municipal, industrial)

WELL COMPLETION DATA:

- (1) diameter (inches) 2"
- (2) total depth (feet) 65
- (3) static water level (feet) 17 below top of ground
- (4) casing P.V.C.  
(material) (depth)

(size) If telescope see back.

- (5) screen 10 ft  
(length) (depth to top)

2" P.V.C.  
(size) (material)

- (6) pump (HP) (yield gpm)

(type power)

- (7) electric log (yes or no)

(organization running log)

- (8) how well bottom plugged Plug


DRILLERS REMARKS:

RECEIVED  
JUN 8 1977

MISS. BD OF WATER COMMISSIONERS

If well telescopes please sketch and show depths.

GROUND LEVEL

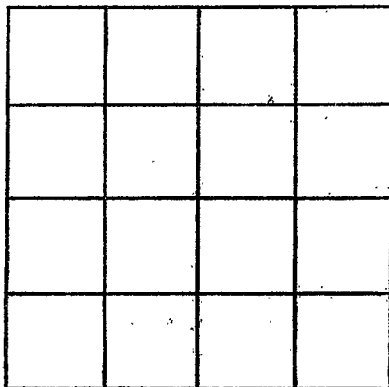

SECTION \_\_\_\_\_

Please indicate well location X.

ADDITIONAL INFORMATION

If more than one screen, show locations of each on sketch.