

MISSISSIPPI DEPARTMENT OF NATURAL RESOURCES

Bureau of Land and Water Resources

Southport Mall

P.O. Box 10631

Jackson, Mississippi 39209

WATER WELL DRILLERS LOG

WASHINGTON  
J  
2001

2-15 1986 Scholtz Drilling Washington  
date well completed firm name county well located


LANDOWNER:	description of formations encountered	from	to
Dillard Land Co. Rt. 1 Box 176 Leland MS (mailing address)			
WELL LOCATION: sec. 25-T-170 R-6 6 miles SE of Leland (distance) (direction) (nearest town)			
WELL PURPOSE: IRRIGATION (home, irrigation, municipal, industrial)			
WELL COMPLETION DATA:			
(1) diameter (inches) 4"			
(2) total depth (feet) 100'			
(3) static water level (feet) 25' below top of ground.			
(4) casing PUC 80' (material) (depth)			
(5) screen 20' 80' (length) (depth to top)			
4" PUC (size) (material)			
(6) pump 1/2 50 (HP) (yield gpm)			
ele (type power)			
(7) electric log NO (yes or no)			
(organization running log)			
(8) how well bottom plugged CAP			
DRILLERS REMARKS:			

RECEIVED  
MAR 18 1986

Department of Natural Resources  
Bureau of Land & Water Resources

If well telescopes please sketch and show depths.

GROUND LEVEL

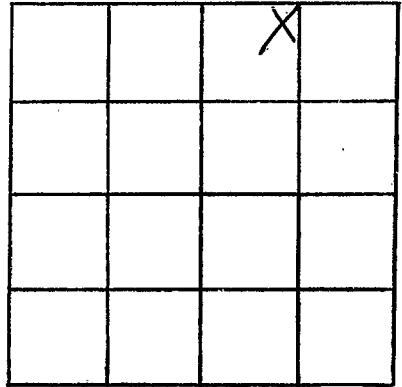

SECTION

25

Please indicate well location X.

ADDITIONAL INFORMATION

If more than one screen,  
show locations of each on sketch.