

MISSISSIPPI DEPARTMENT OF NATURAL RESOURCES

Bureau of Land and Water Resources

Southport Mall

P.O. Box 10631

Jackson, Mississippi 39209

WATER WELL DRILLERS LOG

Washington
I 2003

9-2-87¹⁹
 date well completed

Schultz Drilling
 firm name

Washington
 county well located

LANDOWNER: BEN WALKER
Sniblett, ms 38779
 (mailing address)

description of formations encountered	from	to
SANDY TOPSOIL	0	10
SAND	10	60
SAND + GRAVEL	60	100

WELL LOCATION:
 sec. 3 T. 17 N. R. 6 E.
4 miles SE of LELAND
 (distance) (direction) (nearest town)

WELL PURPOSE: IRRIGATION (TANK FILL)
 (home, irrigation, municipal, industrial)

WELL COMPLETION DATA:

(1) diameter (inches) 4"

(2) total depth (feet) 100'

(3) static water level (feet) 32' - below
 top of ground. above

(4) casing PVC 70'
 (material) (depth)

_____ if telescope see back.
 (size)

(5) screen 30' 70'
4" (length) (depth to top)
PVC
 (size) (material)

(6) pump 3 80
 (HP) (yield gpm)
ele
 (type power)

(7) electric log NO
 (yes or no)
X
 (organization running log)

(8) how well bottom plugged b/w

RECEIVED
 FILE


OCT 28 1987

Department of Natural Resources
 Bureau of Land & Water Resources

DRILLERS REMARKS:

If well telescopes please sketch and show depths.

GROUND LEVEL

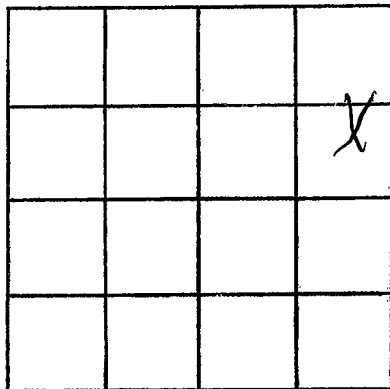

SECTION 3

Please indicate well location X.

ADDITIONAL INFORMATION

If more than one screen, show locations of each on sketch.